


T. 2N., R. 31E., W.M.

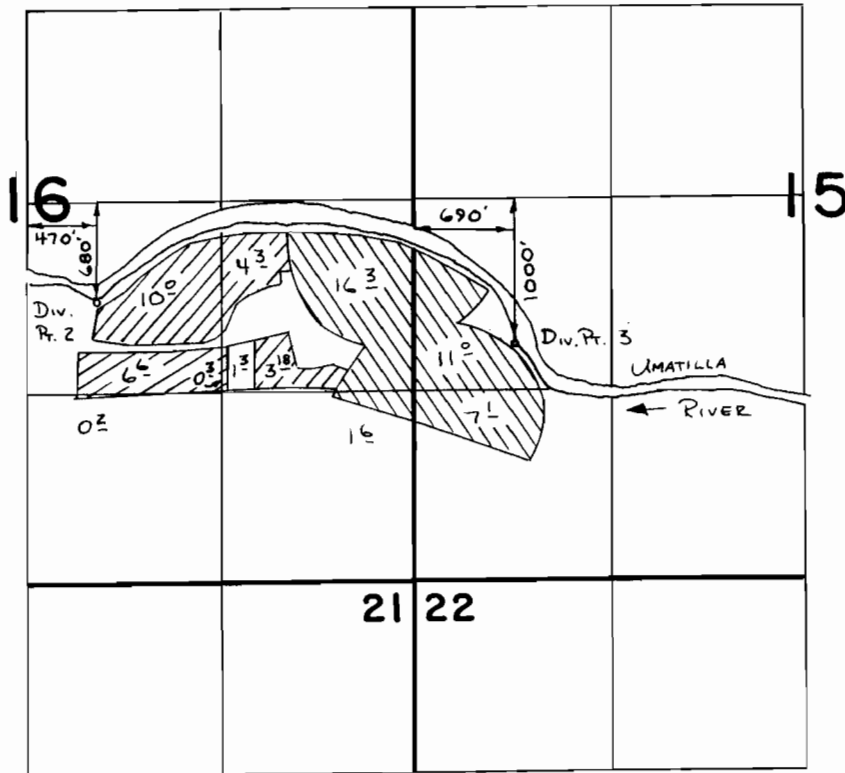

SCALE 1" = 1320'

-  T-5773 Div. Pt. 3
-  T-5774 Div. Pt. 2
-  T-5794 Div. Pt. 2

FINAL PROOF SURVEY
UNDER

TRANSFERS 5774, 5773, 5794
IN NAME OF

.....LEWIS...LIVESTOCK.....INC.....

Surveyed 11-3..... 1988., by V.L. Church.....