
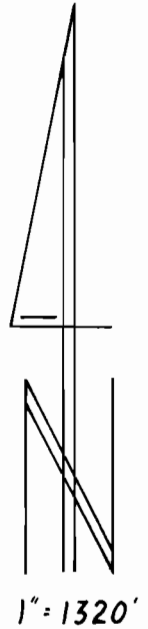


T. 4 S., R. 1 W., W.M.

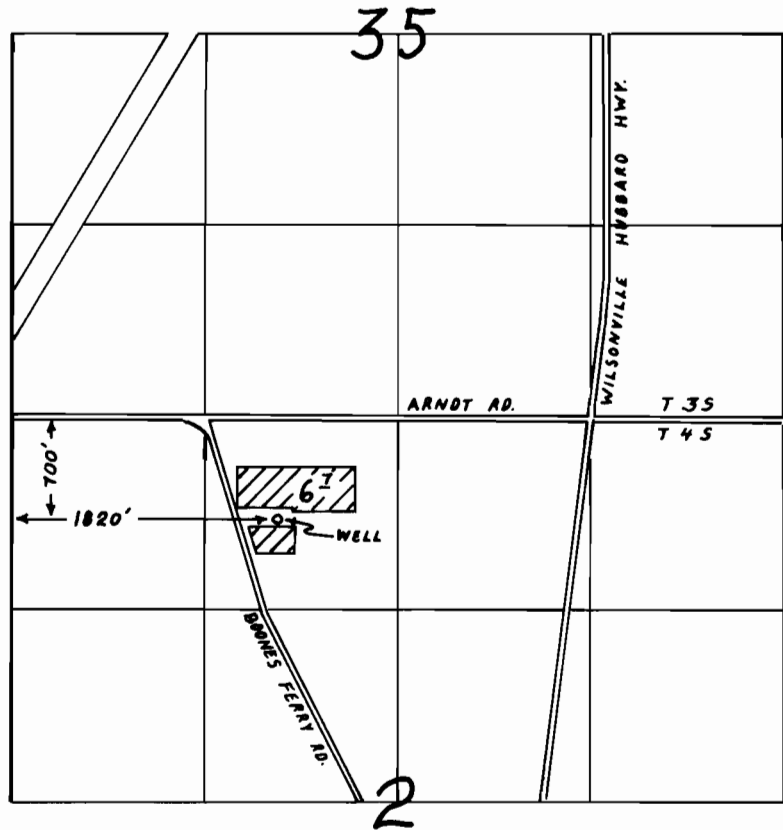

FINAL PROOF SURVEY

UNDER

Application No. G-11609 Permit No. G-10689
IN NAME OF

STANLEY V. SHEPHARD

Surveyed MARCH 13, 1991, by R.W. Klassen