


T. 4 S., R. 22 E., W.M.

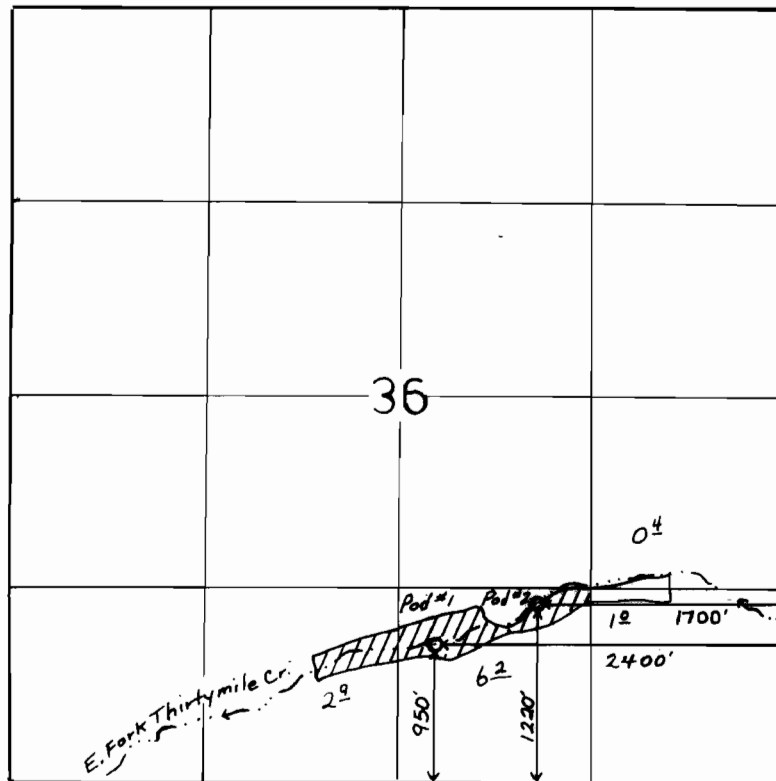

1" = 1320'

FINAL PROOF SURVEY

UNDER

Application No. 67437 Permit No. 48195
IN NAME OF

RUSSELL AND MARVA ERICKSEN

Surveyed 2-4, 1991, by K.KEMP