


T.27S.,R.15E.,W.M.

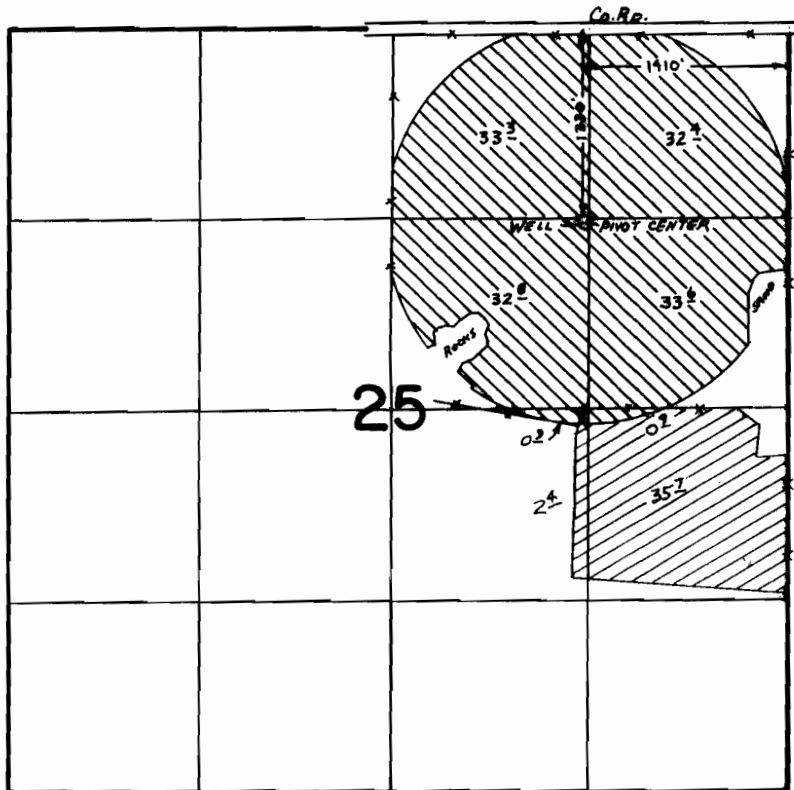

FINAL PROOF SURVEY

UNDER

G-11003 G-10179 
Application No. G-8445 Permit No. G-7842.... 
IN NAME OF

.....**DARREL G. BOWEN**.....

Surveyed July 26, 1983, by L. M. TOLL
Sept. 12 1985 T. M. Warren