


T. 17 S., R. 5 W., W.M.

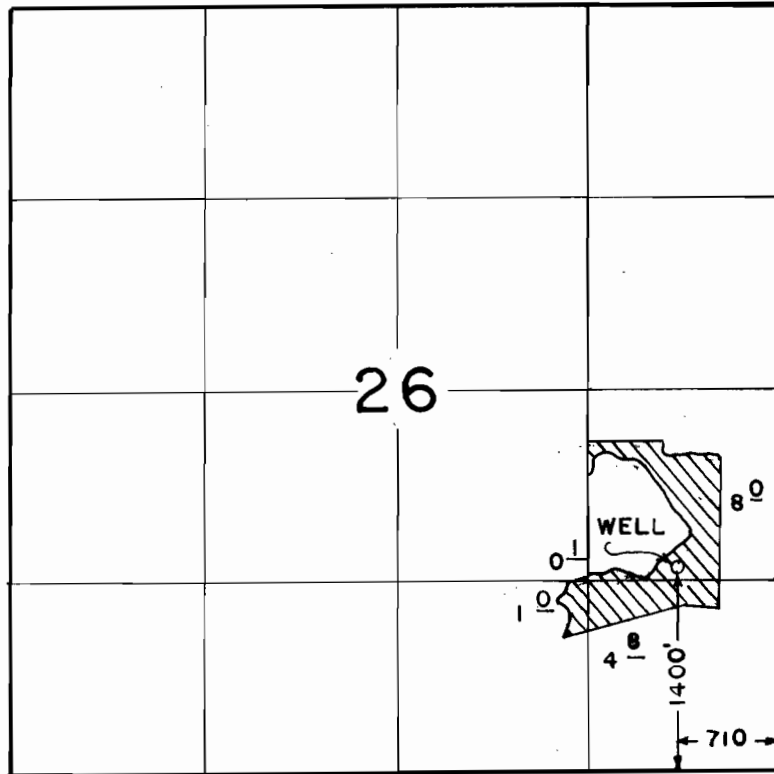

SCALE  
1" = 1320

**FINAL PROOF SURVEY**  
UNDER

Application No. G 9920 Permit No. G 9093  
IN NAME OF

MRS. CAROLINE V. FISHER

Surveyed MAY 7, 1984, by P. PAGTER