


T. 8 S., R. 24 E., W.M.

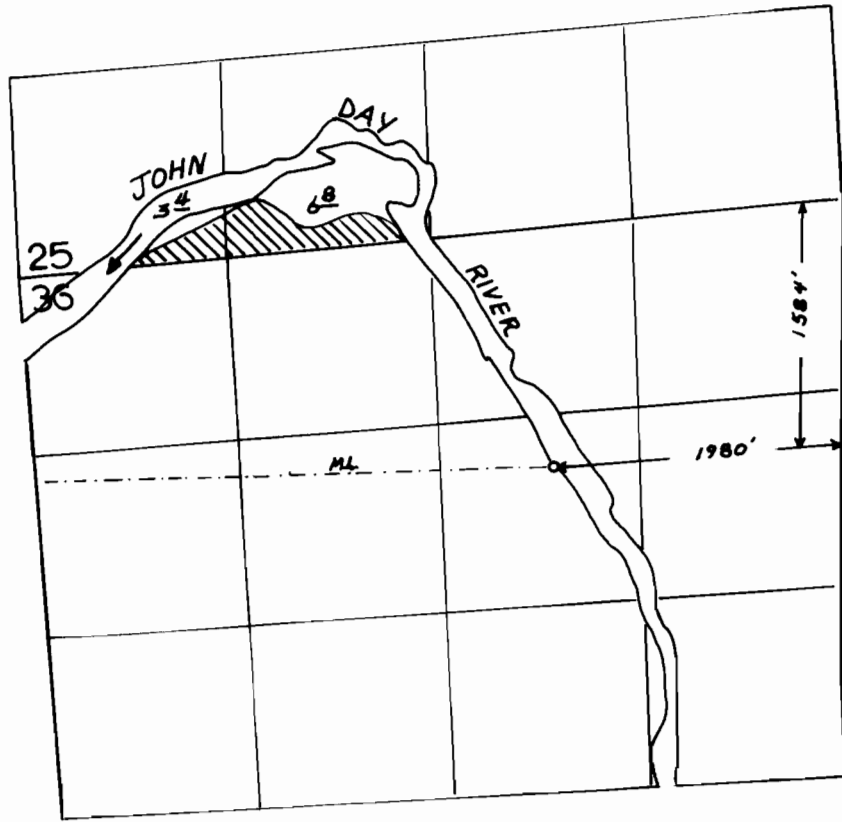

1" = 1320'



FINAL PROOF SURVEY

UNDER

Application No. 68941 Permit No. 49964
IN NAME OF

DON R. JOHNSON

Surveyed 11-12, 1992, by J. MILLER