


RECEIVED

Township 8 South, Range 25 East, W. M.

JUN 12 2001

WATER RESOURCES DEPT.
SALEM, OREGON

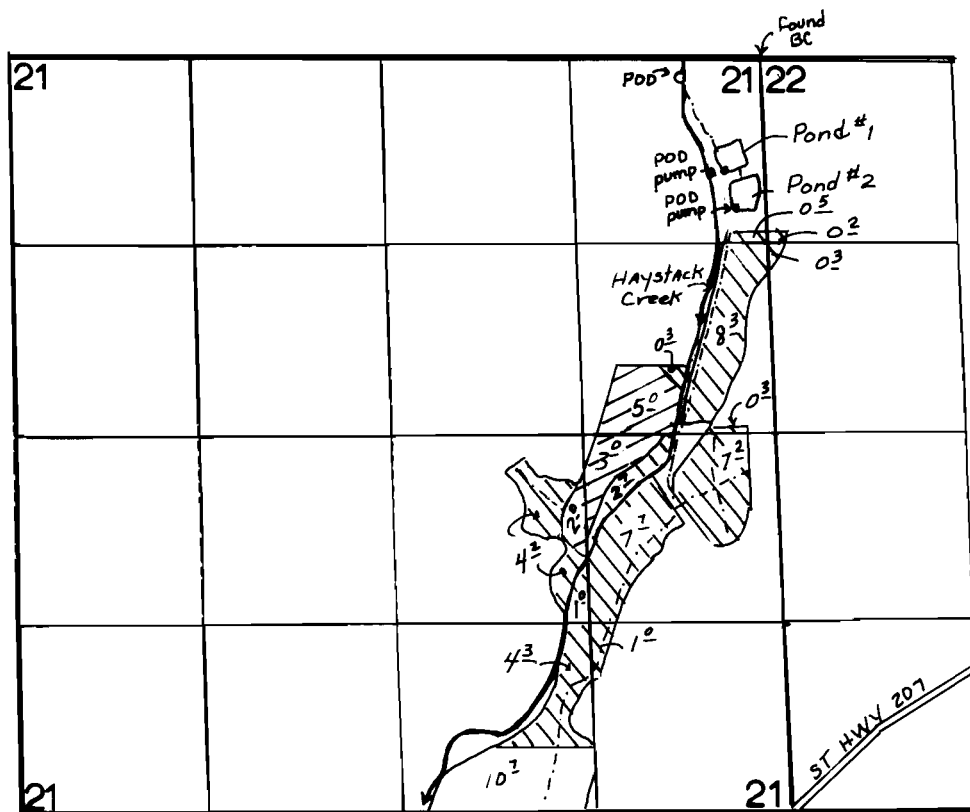

CR. POD - 110' S. & 550' W. FROM THE NE COR. SEC. 21.
POND 1-POD-750' S. & 270' W. FROM THE NE COR. SEC. 21.
POND 2-POD-1030' S. & 210' W. FROM THE NE COR. SEC. 21.



PRIMARY



SUPPLEMENTAL

FINAL PROOF SURVEY UNDER

R-65010 R 8664
Application No. 65011.... Permit No. 47606.....
IN NAME OF

.....THEODORE J. KLEKAMP.....

Surveyed 6/15..... 2000., by J. MILLER.....

1" = 1320'