T. 2 N., R. 1 W., WM

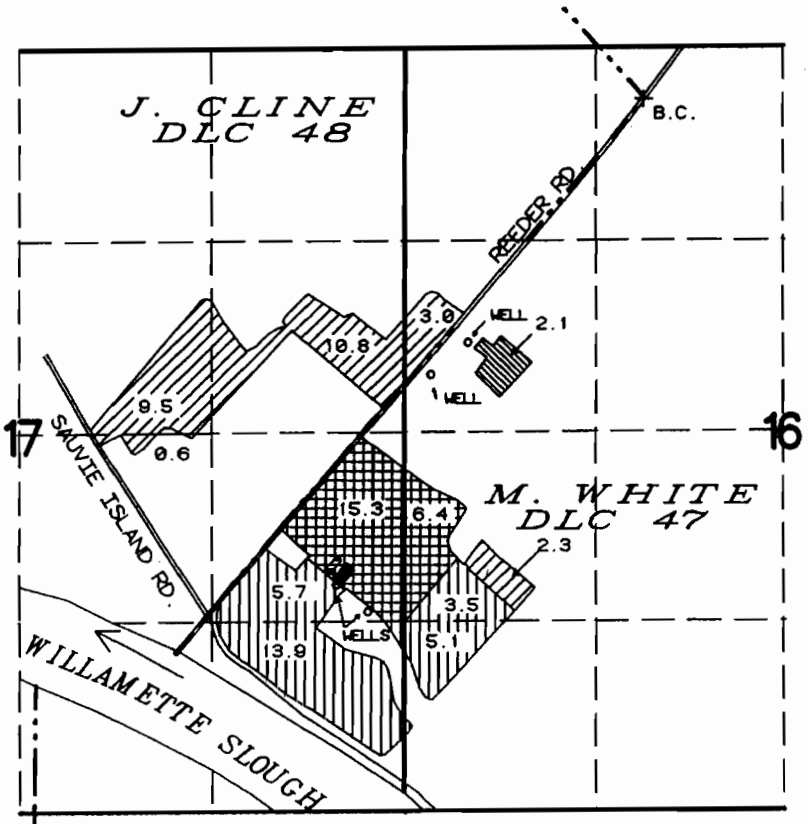

N

1" = 1320 FT

GREENHOUSE

G-9539 PRIMARY IRR.

G-9541 SUPPLENTAL IRR.
G-9539 SUPPLEMENTAL IRR.

G-9539 SUPPLEMENTAL IRR.

G-9540 PRIMARY IRR.
G-9753 SUPPLEMENTAL IRR.

CONTAINERIZED STOCK
(0.1 ACRE)

WELL LOCATION FOR PERMIT

9753 - 2020 FT S AND 440 FT E FROM THE NW CORNER SECTION 16

9540 - 2240 FT S AND 180 FT E FROM THE NW CORNER SECTION 16

9541 - 1560 FT N AND 460 FT W FROM THE SE CORNER SECTION 17

9539 - 1380 FT N AND 250 FT W FROM THE SE CORNER SECTION 17

FINAL PROOF SURVEY

UNDER

G-9743 G-9539
G-9744 G-9540
G-9745 G-9541

Application No.: G-10632 Permit No.: G-9753

IN THE NAME OF

PACIFIC COAST NURSERY

Surveyed: MAY 13, 1987 By: T. M. WARREN

RWK

DFO 2LL 108