


30 T. 1 & 2 S., R 22 E., W.M.

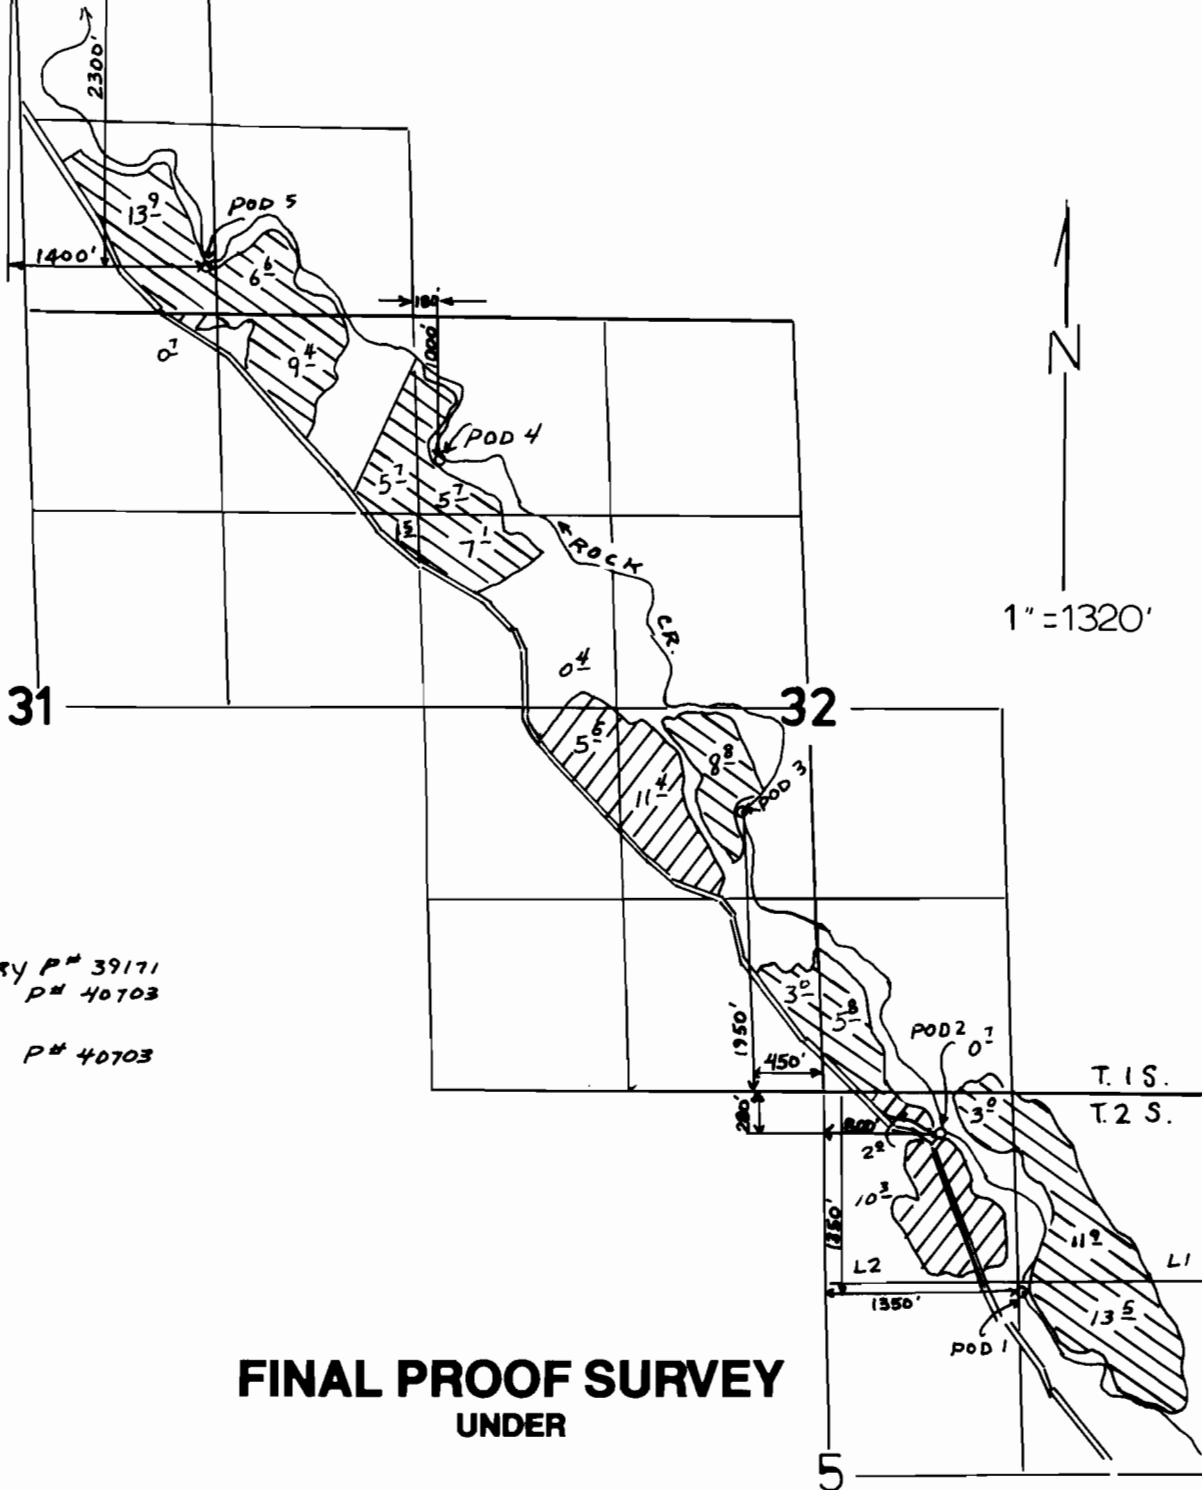

**FINAL PROOF SURVEY**  
UNDER

53673 39171  
Application No. 53673. Permit No. 40703.....  
IN NAME OF

...HARRISON...M...WEATHERFORD...

Surveyed March 14, 2000, by J. MILLER..