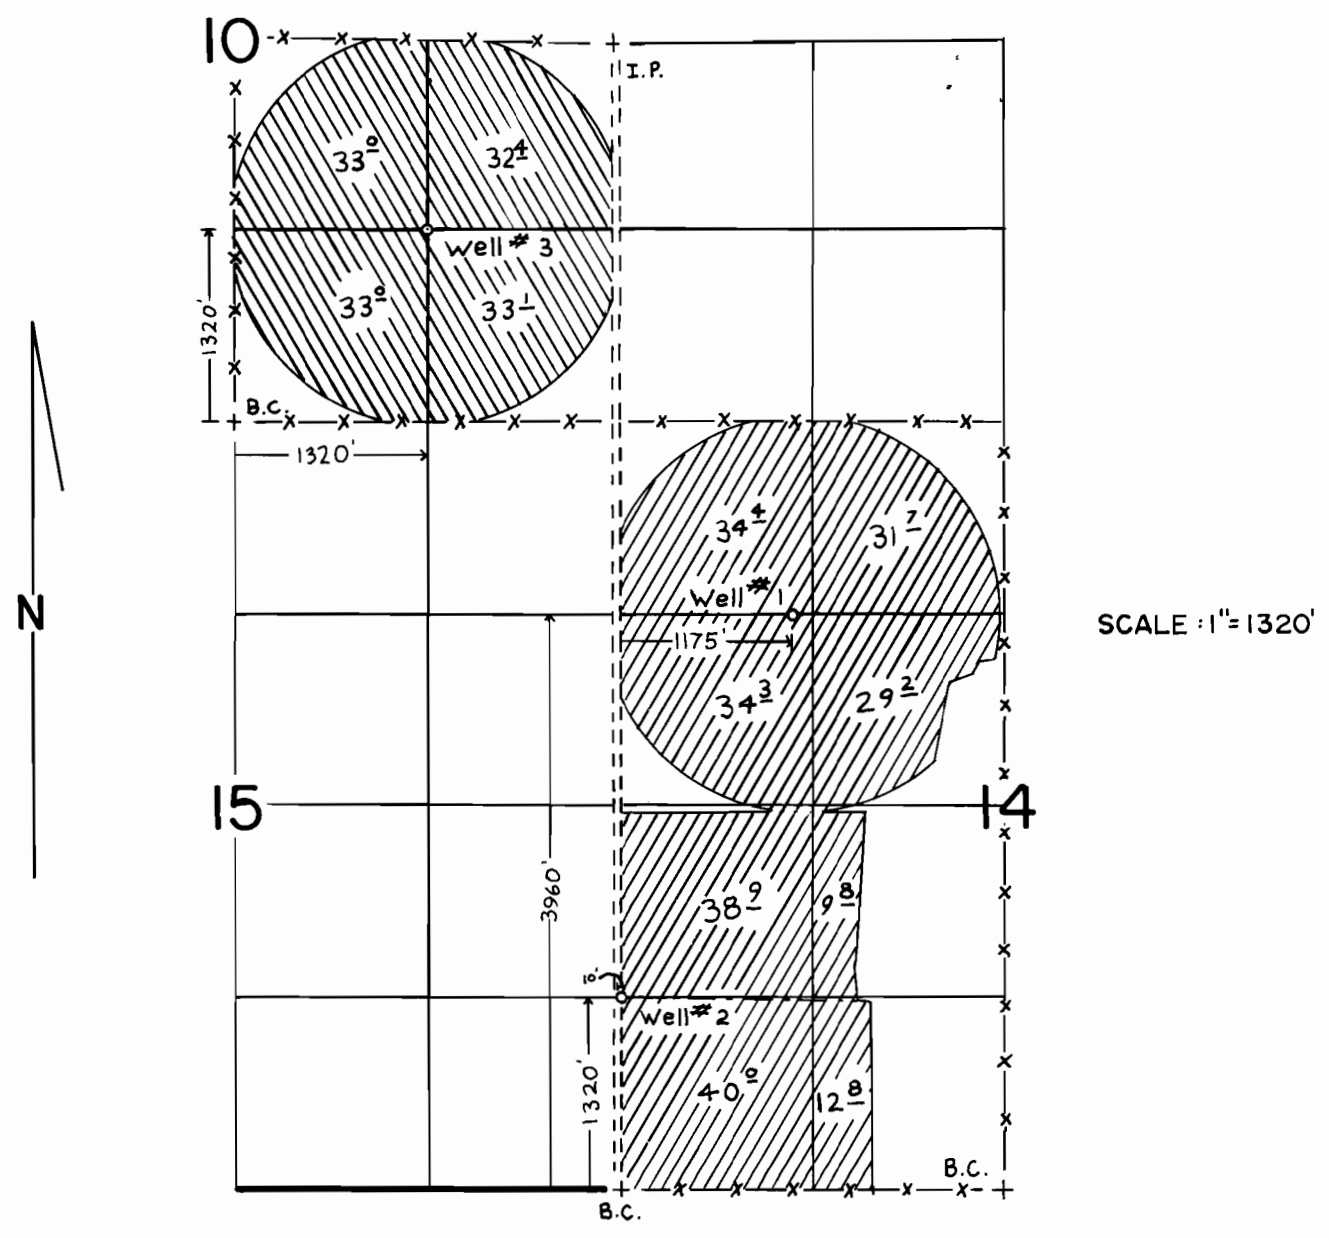

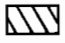


T. 26S., R. 16E., W. M.



FINAL PROOF SURVEY UNDER

G-9886 G-9141 
 Application No. G-10328. Permit No. G-9356..... 
 IN NAME OF

.....**MERVIN STUTZMAN**.....

Surveyed MAY. 14, 15, 1985., by LESLIE OLSON.....