


T.17S. R.21E. W.M.

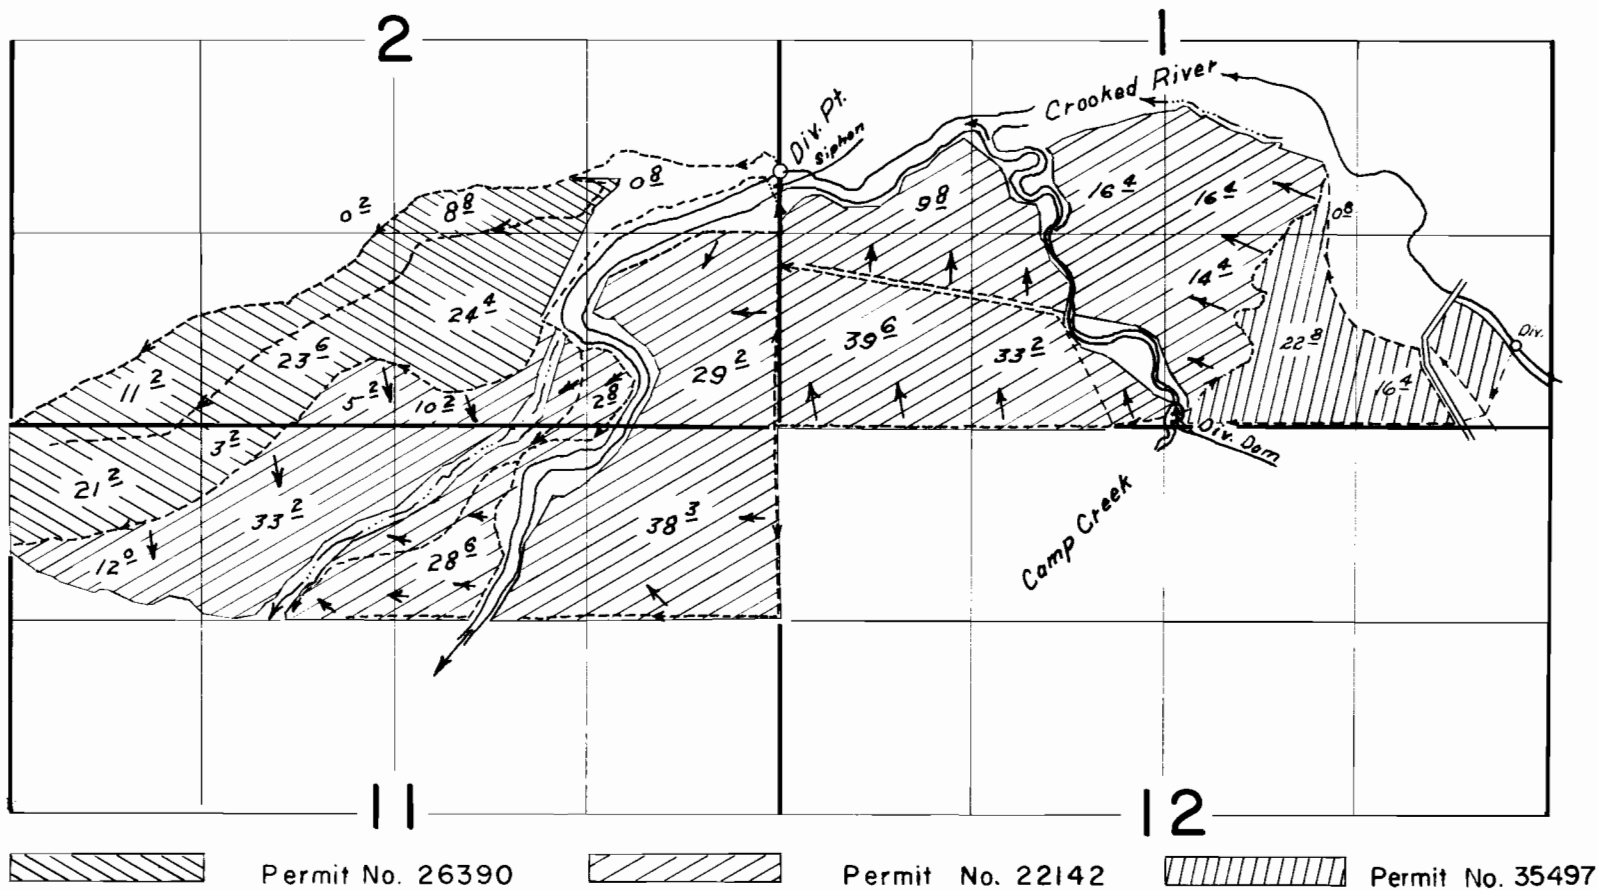

FINAL PROOF SURVEY
UNDER
Application Nos. 47742, 28130, 33409 Permit Nos. 35497, 22142, 26390
IN NAME OF
GALE MERWIN
Aug. 4, 1977 D. NORBY
Surveyed Sept. 29, 30, 1964 By: R. Jackson