


TOWNSHIP 9 SOUTH, RANGE 6 WEST, W.M.

SW 1/4 Section 1

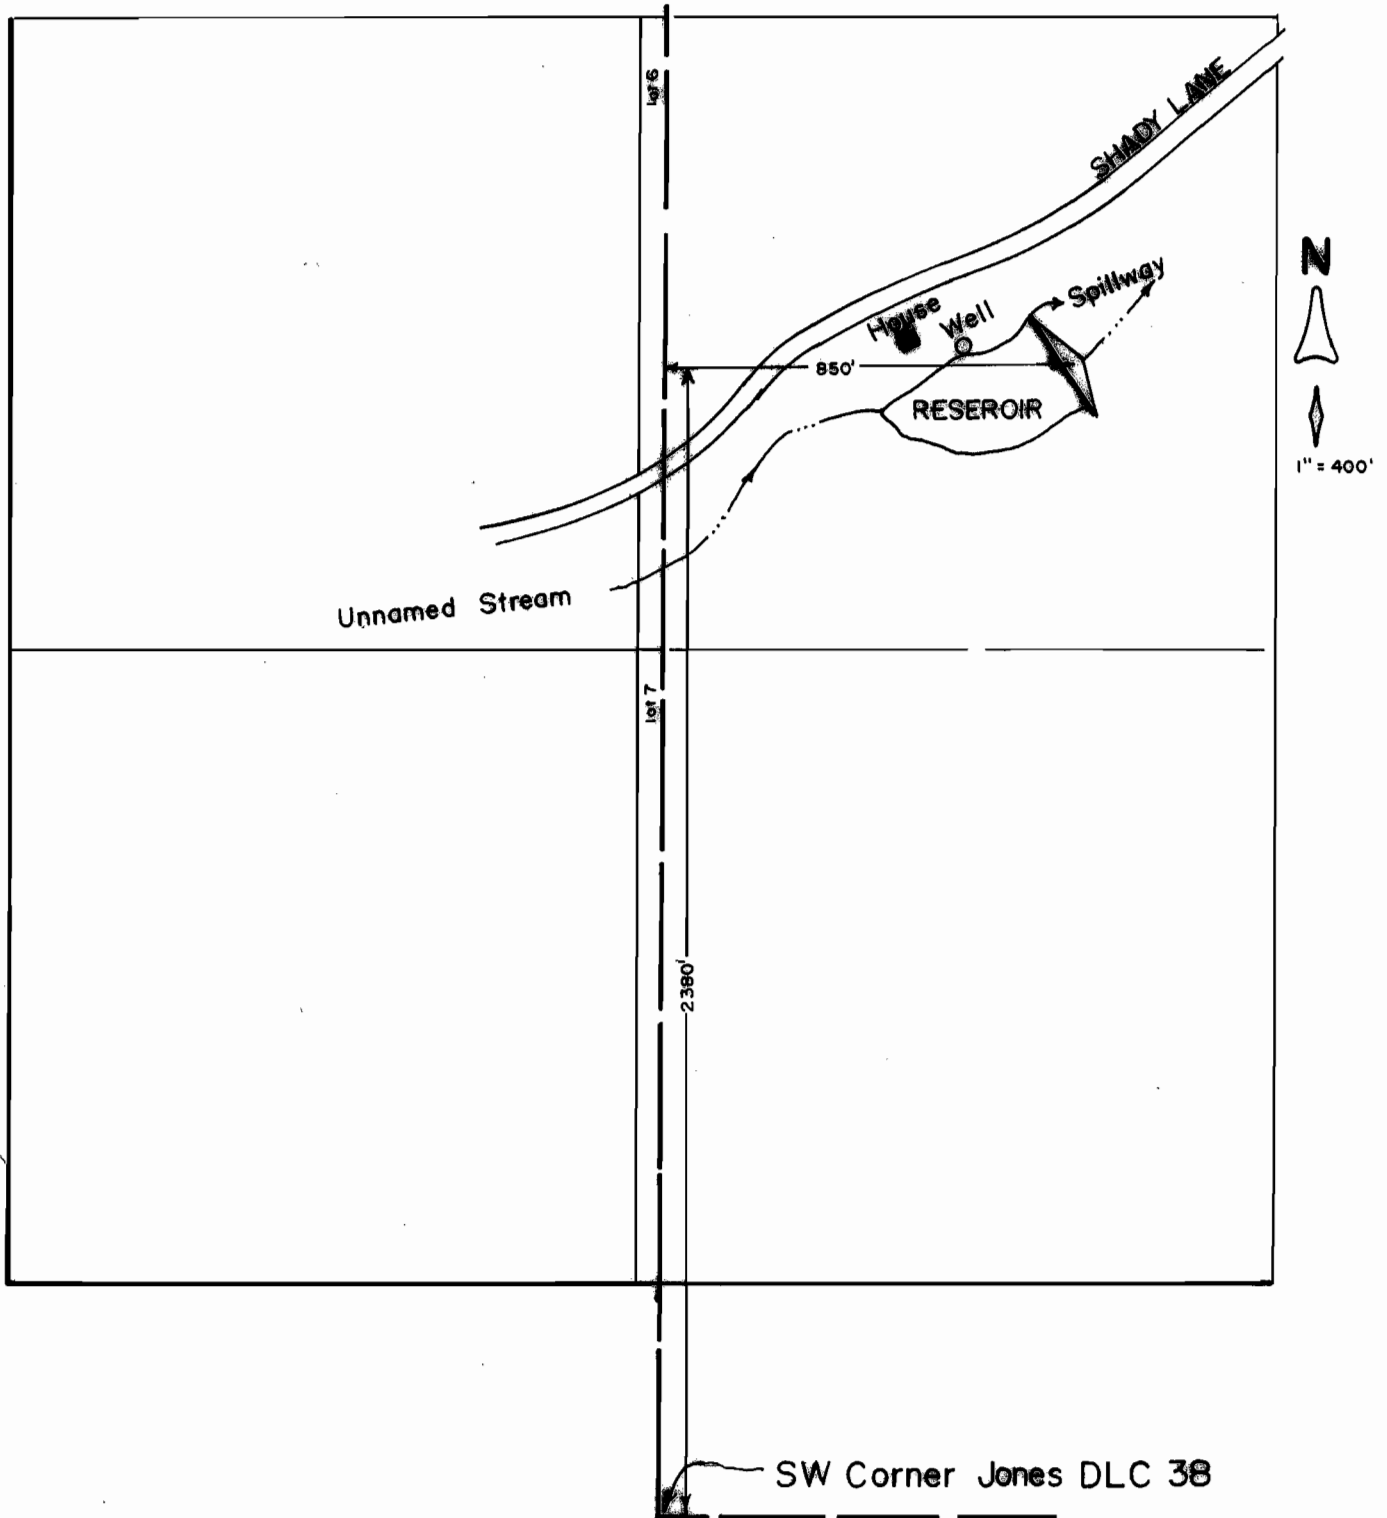

FINAL PROOF SURVEY
under


Appl. No. 73822, Per. No. 52062
in name of

RICHARD KINDWALL
Nov. 11, 1999

RECEIVED

MAY 05 2000

WATER RESOURCES DEPT.
SALEM, OREGON

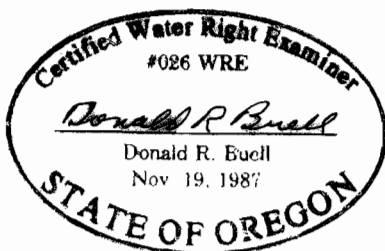

THIS MAP WAS PREPARED FOR THE PURPOSE OF IDENTIFYING THE LOCATION OF A WATER RIGHT ONLY AND IS NOT INTENDED TO PROVIDE LEGAL DIMENSIONS OR LOCATION OF PROPERTY OWNERSHIP LINES.