


T.3S.R.4W.W.M.

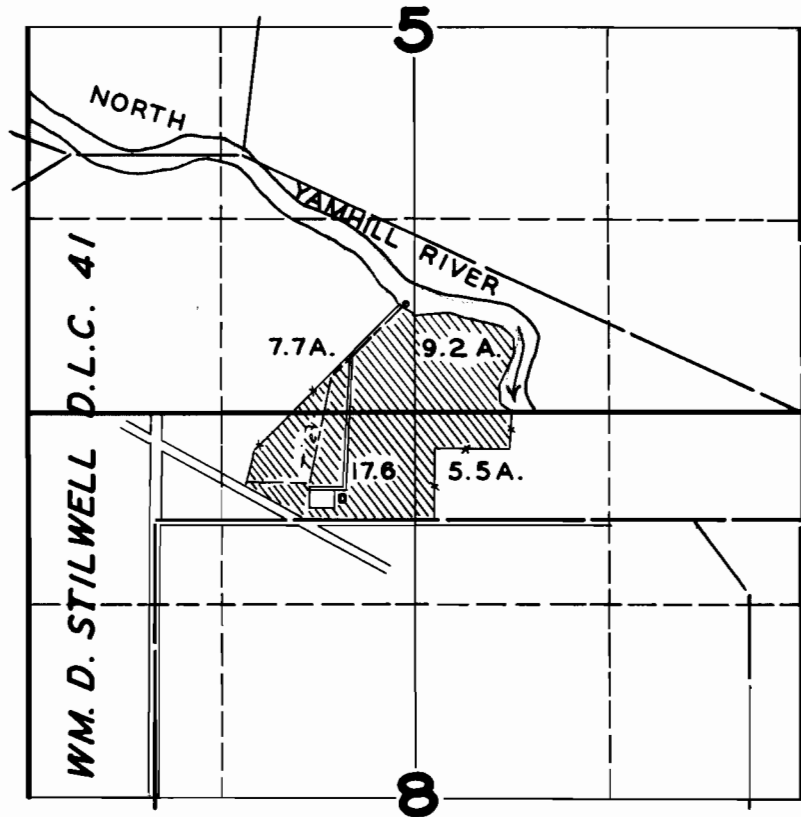

FINAL PROOF SURVEY

UNDER

17592

13288

Application No. 18229 Permit No. 13890

IN NAME OF

FRANK M. TRIVELPIECE

Surveyed APR. 3 1947, by JAS. E. BUNNELL