



FINAL PROOF MAP T-8951
NE1/4NE1/4, SEC. 4, T.39S., R.3W., W.M.
JACKSON COUNTY, OREGON
FOR
HOWARD R. AND DIANE M. JUUL
361 HAMILTON ROAD
JACKSONVILLE, OR 97530

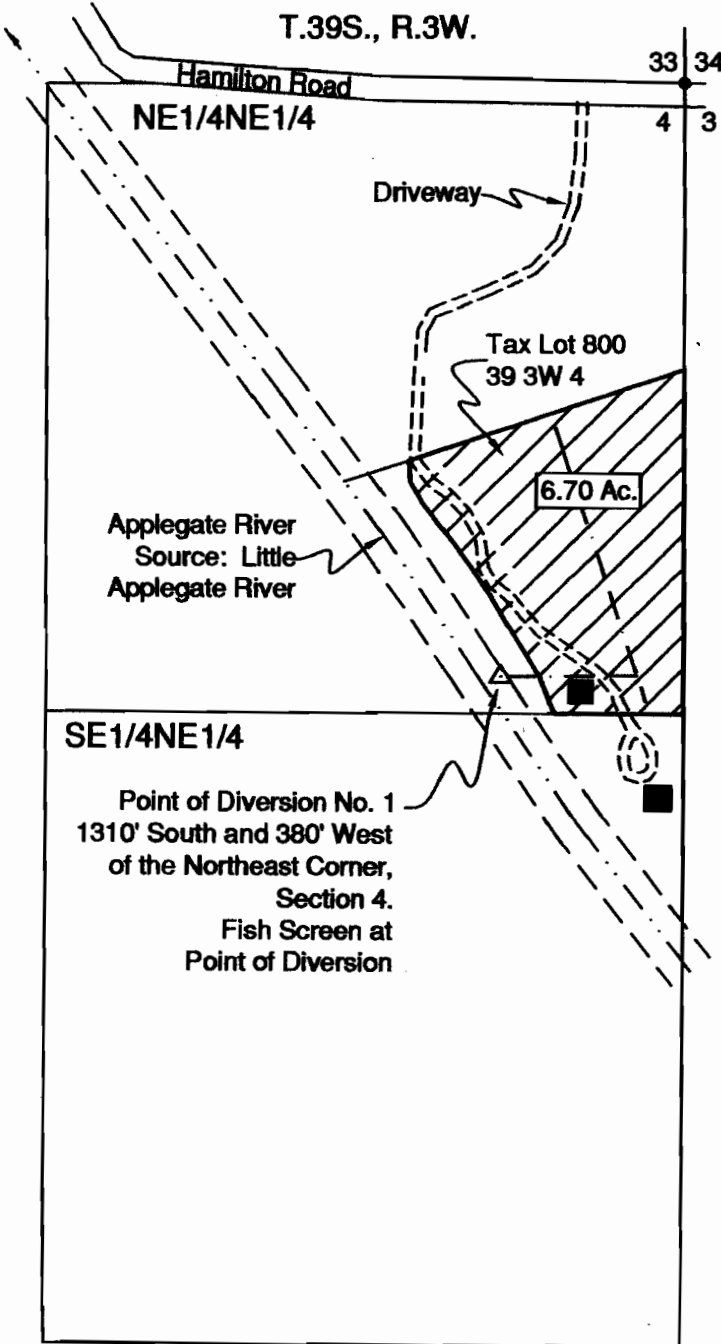

Scale: 1"=400'
Date: July 17, 2006

LEGEND

- Found Survey Monument
- Denotes Building
- Denotes Main Pipeline
- ▨ Denotes Area Under Special Order Volume 64, Pages 431-434, Priority Date Sept. 1, 1857

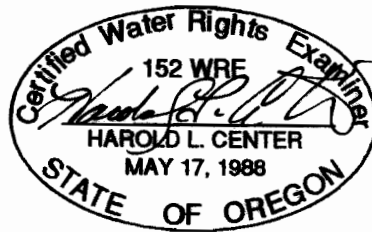

HAROLD L. CENTER
 2604 David Lane
 Medford, OR. 97504
 Phone 541-535-6108
 Oregon Certificate No. 152
 Certificate Renewal Date: 12/31/2007

This map was prepared for the purpose of identifying the location of a water right only and is not intended to provide legal dimensions or location of property ownership.

RECEIVED
 OCT 10 2006
 WATER RESOURCES DEPT
 SALEM, OREGON