

EXPLANATION

EXISTING SIXTEENTH LINES

 DLC 38

WATER RESOURCES DEPT
 SALEM, OREGON

APR 04 2007
RECEIVED


NOTES

- 1 THIS MAP WAS PREPARED FOR THE PURPOSE OF IDENTIFYING THE LOCATION OF WATER RIGHTS ONLY AND IS NOT INTENDED TO PROVIDE LEGAL DIMENSIONS OR LOCATIONS OF PROPERTY OWNERSHIP LINES.
- 2 PLACE OF USE FOR WATER IS SHOWN ON FIGURE 1.
- 3 MAP BASED ON WATER RIGHT CERTIFICATES AND INFORMATION PROVIDED BY THE CITY OF ALBANY. DEPICTED CONDITIONS HAVE BEEN VERIFIED BY FIELD OBSERVATIONS.

Point of Diversion
 Proof of Beneficial Use - Transfer T-8276
 City of Albany, Oregon

NEWTON
 CONSULTANTS INC.
 Earth, Water and Rock Specialists
 Ph: 541 504-9960 Fax: 541 504-9961

SEC 33, T. 10S., R. 3W., W.M. / SEC 32, T. 10S., R. 3W., W.M. / SEC 5, T. 11S., R. 3W., W.M.
 SEC 4, T. 11S., R. 3W., W.M. / SEC 9, T. 11S., R. 3W., W.M.
 Linn County, Oregon

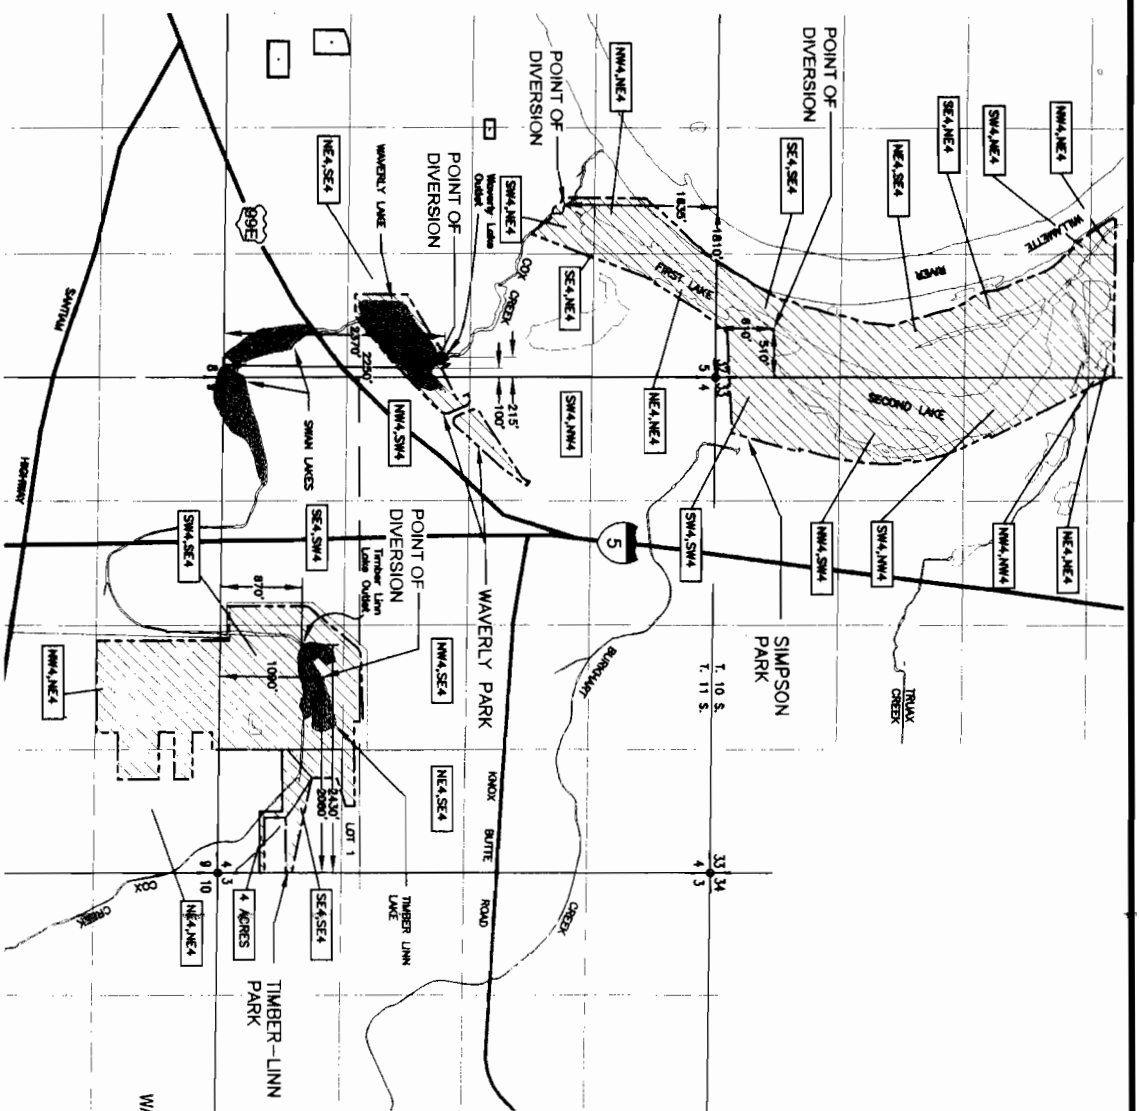

EXPLANATION

- CERTIFICATE 56763
- CERTIFICATE 45179
- PLACE OF USE
- EXISTING SIXTEENTH LINES
- QUARTER-QUARTER SECTION OF PROPOSED PLACE OF USE
- IRRIGATION ACREAGE TRANSFER FROM CERTIFICATE 11155


NOTES

1. THIS MAP WAS PREPARED FOR THE PURPOSE OF IDENTIFYING THE LOCATION OF WATER RIGHTS ONLY AND IS NOT INTENDED TO PROVIDE LEGAL DIMENSIONS OR LOCATIONS OF PROPERTY OWNERSHIP LINES.
2. POINTS OF DIVERSION FOR SOUTH SANTIAM RIVER AND COX CREEK WATER ARE SHOWN ON FIGURE 2.
3. MAP BASED ON WATER RIGHT CERTIFICATES AND INFORMATION PROVIDED BY THE CITY OF ALBANY. DEPICTED CONDITIONS HAVE BEEN VERIFIED BY FIELD OBSERVATIONS.

RECEIVED

APR 04 2007

WATER RESOURCES DEPT
 SALEM, OREGON

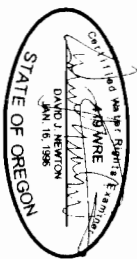

NEWTON
 CONSULTANTS INC.
 Earth, Water and Rock Specialists
 Ph: 541 504-9960 Fax: 541 504-9961



Place of Use
 Proof of Beneficial Use - Transfer T-8276
 City of Albany, Oregon