


T. 29 S, R. 33 E, W.M.

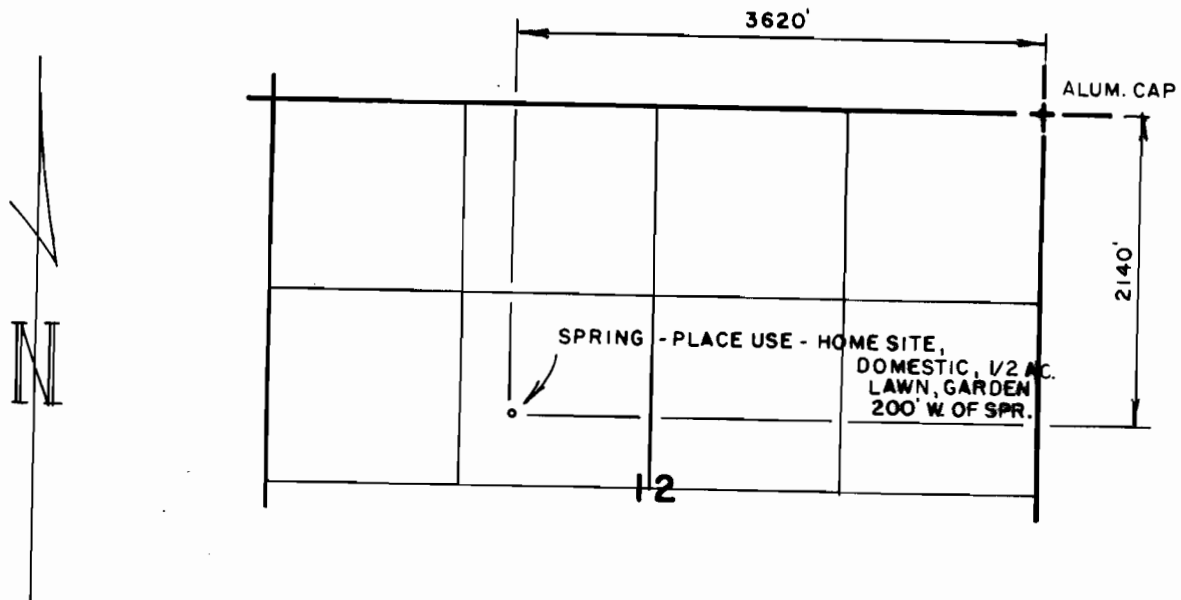

THE PURPOSE OF THIS MAP IS ~~TO~~
 IDENTIFY THE LOCATION OF THE
 WATER RIGHT. IT IS NOT INTENDED
 TO PROVIDE INFORMATION RELATIVE
 TO THE LOCATION OF PROPERTY
 OWNERSHIP

	FINAL PROOF SURVEY		
	UNDER APPLICATION NO. 70005 PERMIT NO. 51020		IN THE NAME OF RIDDLE RANCH, INC
	Scale: 4" = 1 MILE	Date: AUG 1994	Job: 1179 E
	Dgn: Dwn: CHRIS Ckd:	M. A. PALMER & SONS, INC. ENGINEERING & SURVEYING 254 N. Alder - Box 61 Burns, Oregon 97720	
	Sht. No. _____ of _____		