


T. 28 S, R. 34 E, W.M.

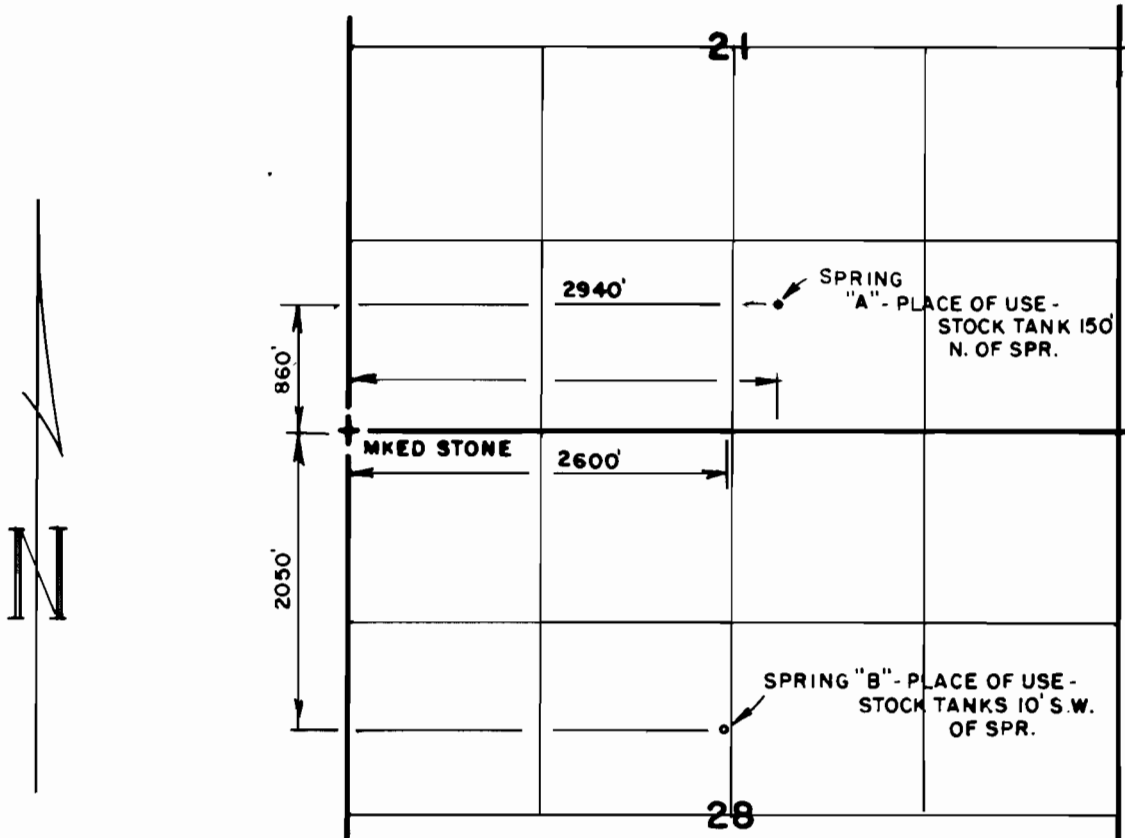

THE PURPOSE OF THIS MAP IS TO IDENTIFY THE LOCATION OF THE WATER RIGHT. IT IS NOT INTENDED TO PROVIDE INFORMATION RELATIVE TO THE LOCATION OF PROPERTY OWNERSHIP.

	FINAL PROOF SURVEY		
	UNDER APPLICATION NO. 70004 PERMIT NO. 51019		IN THE NAME OF RIDDLE RANCH, INC
	Scale: 4" = 1 MILE	Date: AUG 1994	Job: 1179A
	Dwn: CHRIS Ckd:	M. A. PALMER & SONS, INC. ENGINEERING & SURVEYING 254 N. Alder - Box 61 Burns, Oregon 97720	
	Sht. No. _____ of _____		