


TOWNSHIP 14 SOUTH, RANGE 14 EAST, W.M.

RECEIVED


OCT 18 1988

WATER RESOURCES DEPT.  
Salem, Oregon

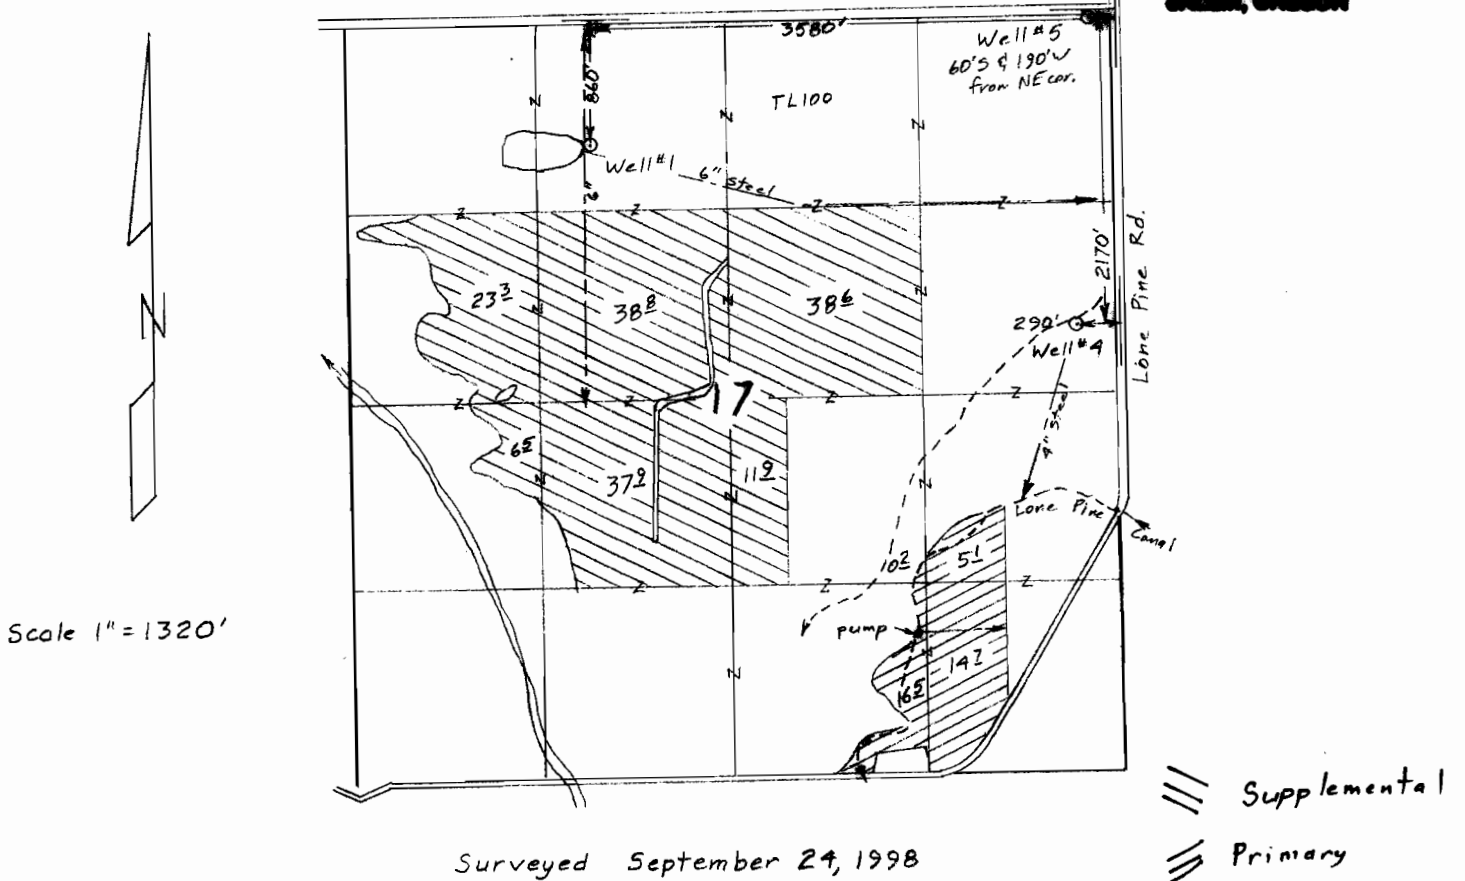

Claim of Beneficial Use Map  
for  
TY FEHRENBACHER

Application G-12743    § T-7853  
Permit G-11774

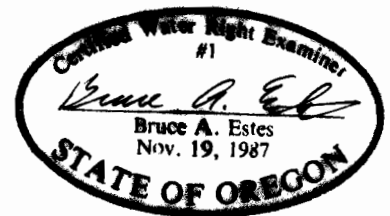

This map is for the purpose of locating a water right only and has no intent to provide legal dimensions or the location of property lines.

**ESTES SURVEYS**  
 6298 Sunnyview Rd. NE    66882 Arnold Rd.  
 Salem, OR 97305    Bend, OR 97702  
 (503) 585-7998    (503) 338-7901