


T.2S. R.3E. W.M.

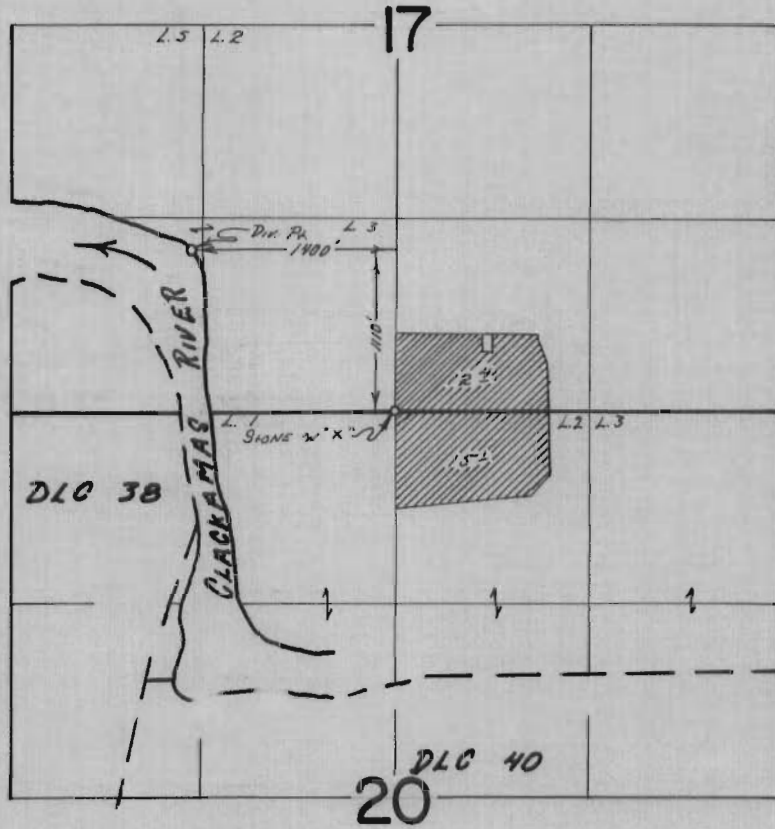

**FINAL PROOF SURVEY**  
UNDER

Application No. 47675 Permit No. 34997  
IN NAME OF

WADE NEWBIGIN

Surveyed SEP. 14 1972, by R. B. MUSKEN