


10 1W 17

SCIO

8 9  
17 16

Scale 1" = 400'

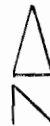

NE COR.  
JOSEPH BOYCE NOT. 4377  
& SE 1/4, NE 1/4, SEC. 17

SEE MAP 10 1W 16

RECEIVED


APR 03 2007

WATER RESOURCES DEPT  
SALEM, OREGON

NOTE: 1/4 COR.  
LIES S 86° 27' E 11"  
FROM PT. QNR/W/C/L  
N 00° 04' 05" W 1320.17  
FROM STA 78+00

FRANKLIN BUTTE RD  
(ORD 85-663 V.11 P.277 RD. RECORDS)

TO R/W/C/L STA 78+00  
FROM R/W/C/L STA 78+00

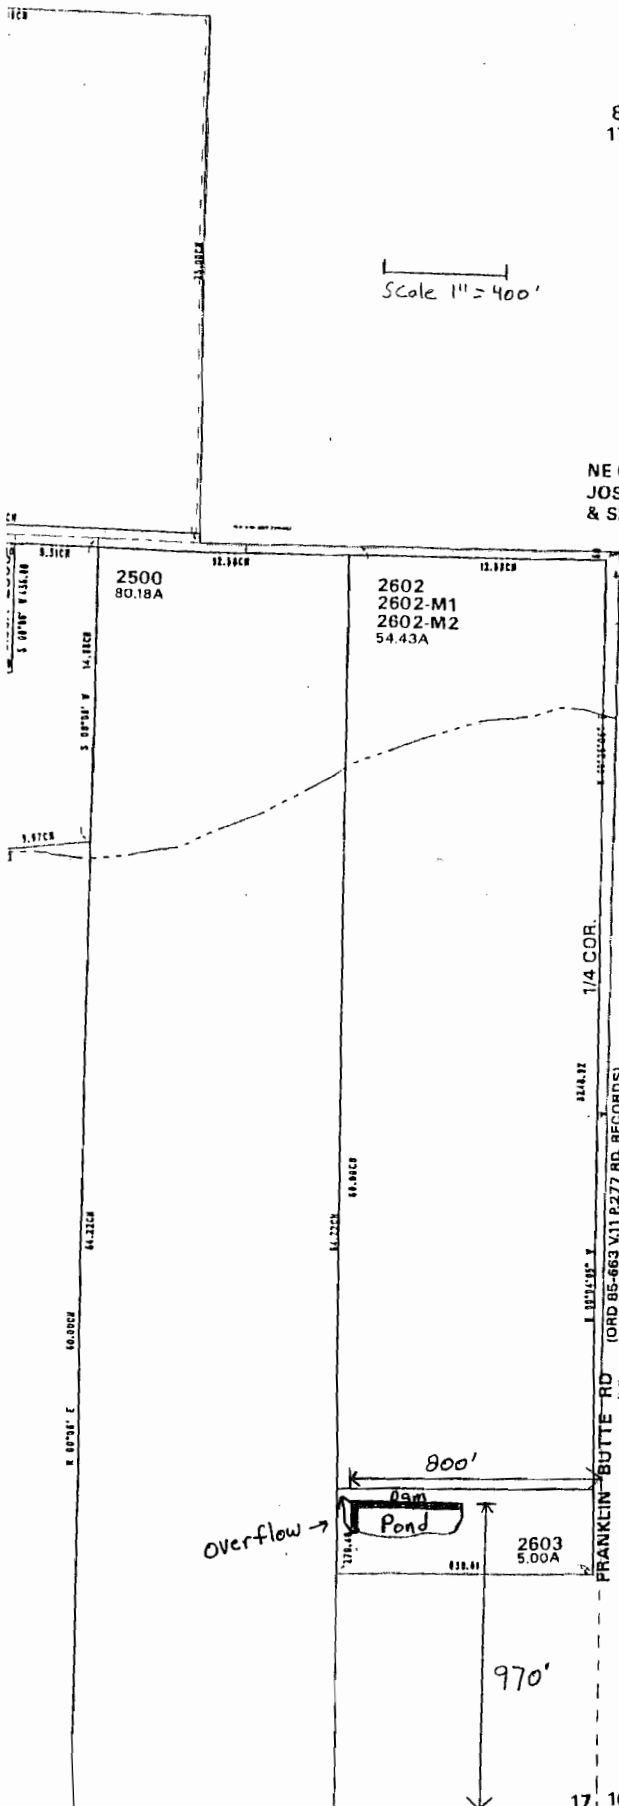

Pond To Be used To  
irrigate From Time To  
Time, any and all parts  
of Tax Lot 2603

RECEIVED  
NOV 02 2006  
WATER RESOURCES DEPT  
SALEM, OREGON

17 16  
20 21