


T. 37 & 38 S., R. 11 E., W.M.

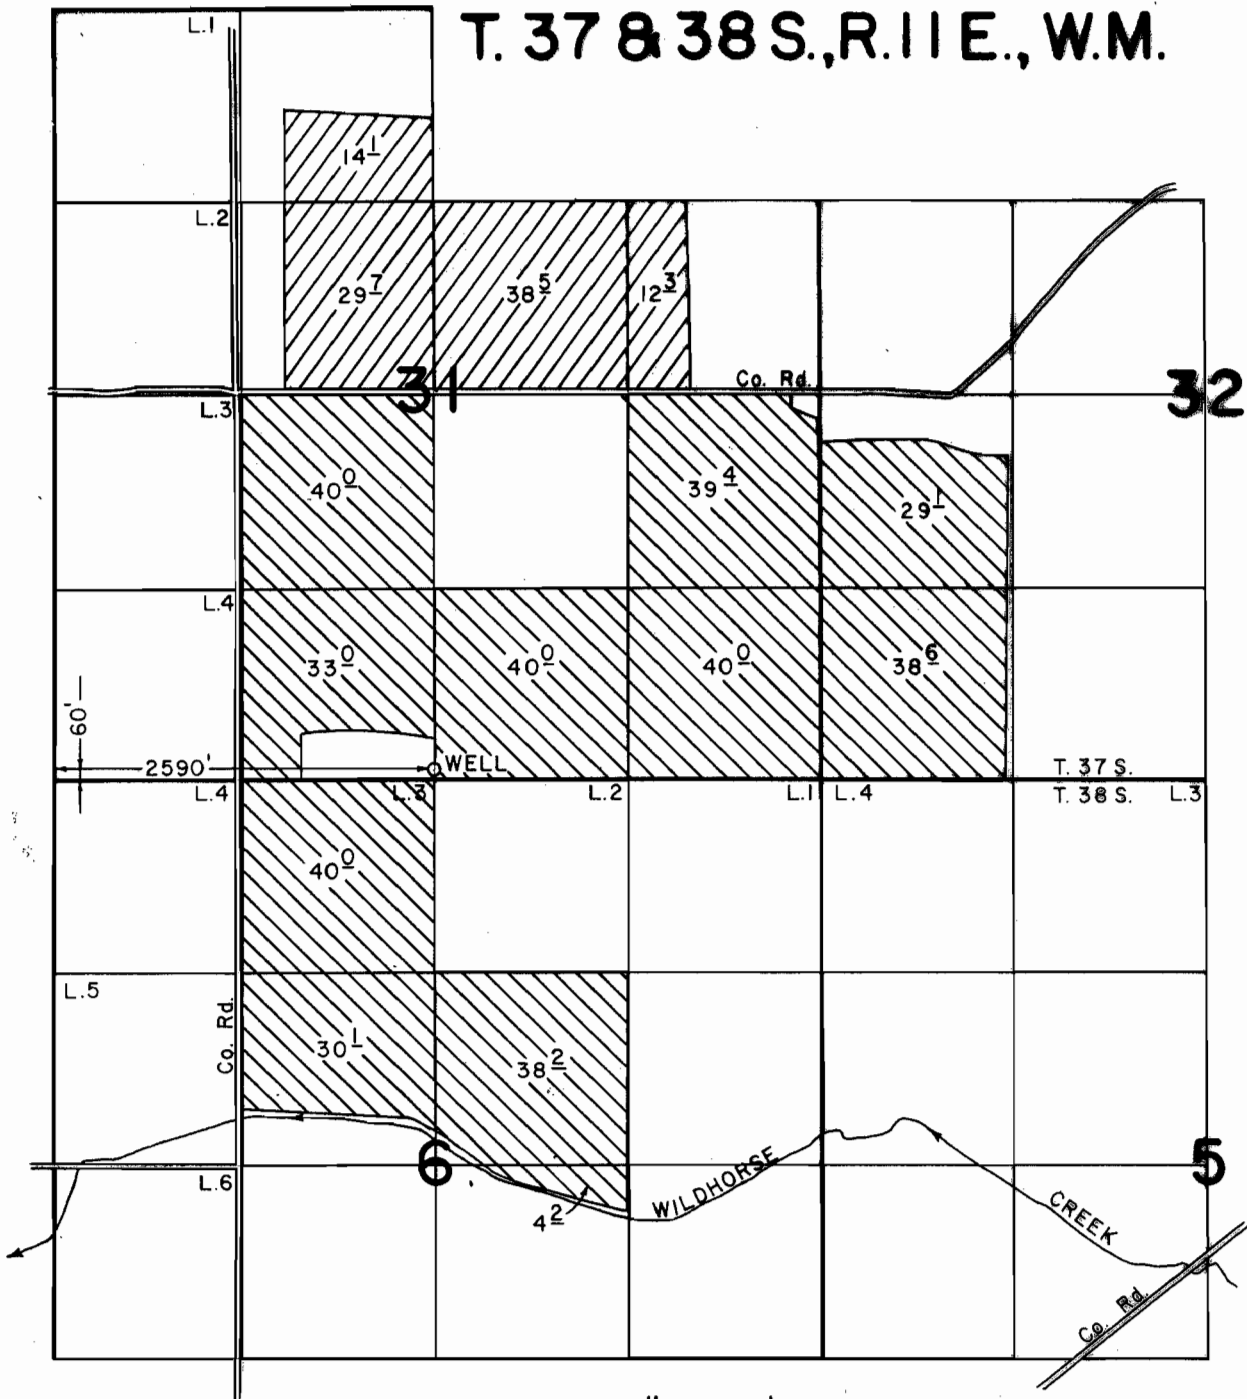

SCALE: 1" = 1320'

FINAL PROOF SURVEY UNDER

G-10429

G-9424



Application No. G-6868, Permit No. G-6404



IN NAME OF

MICHAEL B. JAGER

Surveyed SEPT. 25, 1989, by B. W. BISHOP