


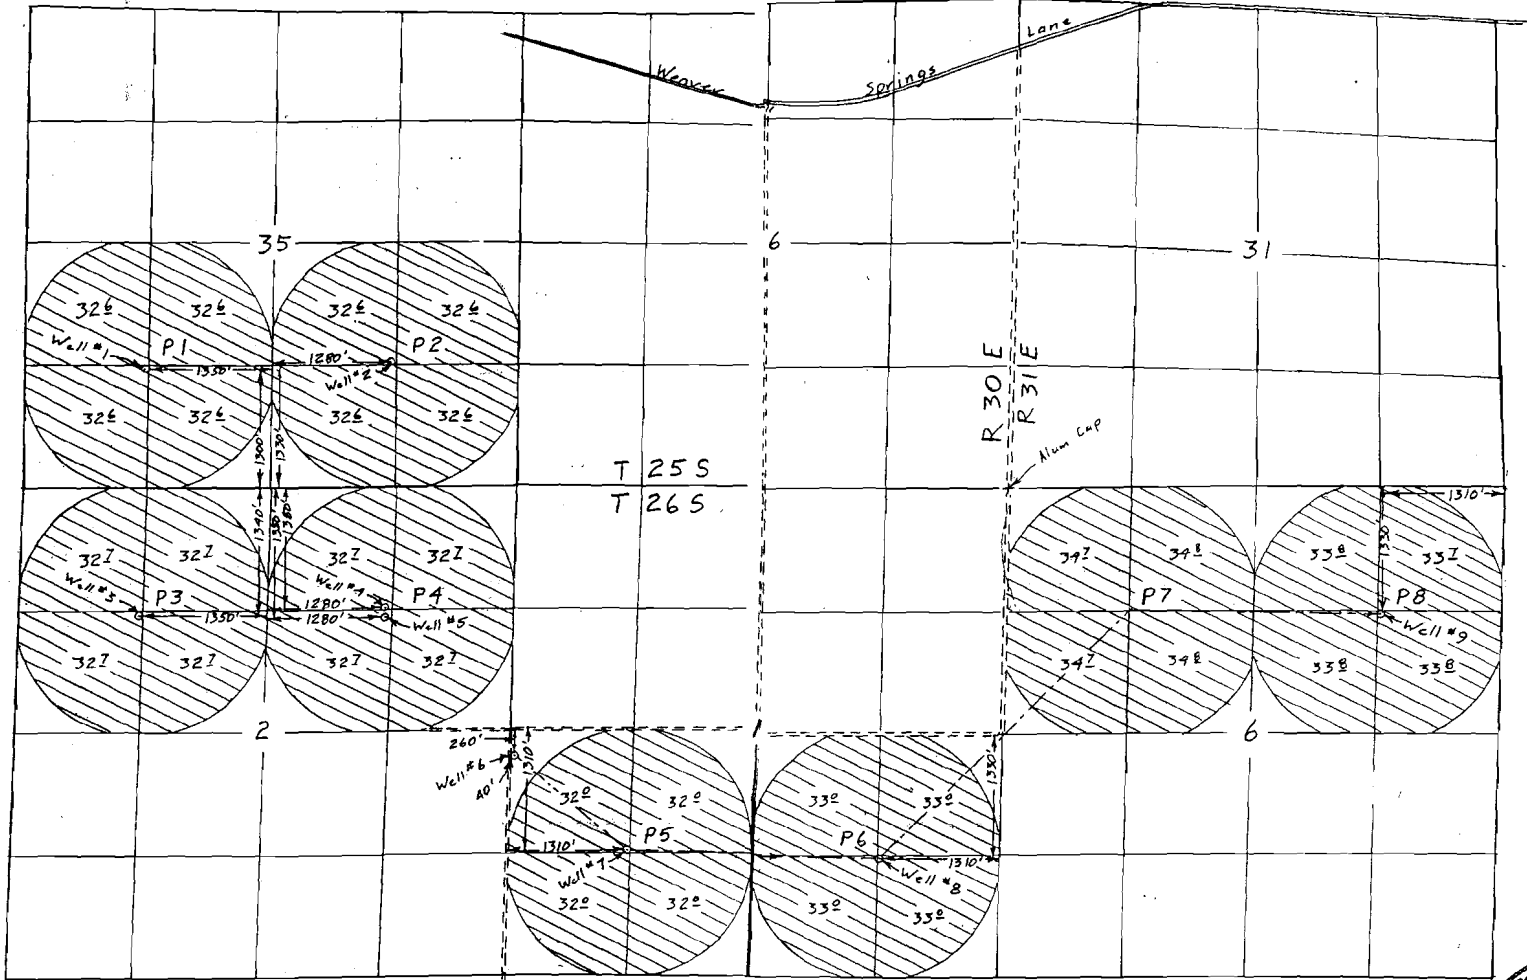

Scale 1"=1320'
(4"=1 mile)



T 25 S
T 26 S


R 30 E
R 31 E

App G-9764
Per G-8979

RECEIVED
 APR 27 2005
 WATER RESOURCES DEPT
 SALEM, OREGON

Surveyed Sep 29, 2003

1056 1/2 acres

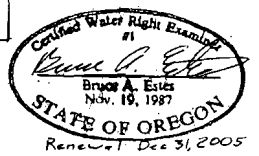

Claim of Beneficial Use Map
for
HERB VLOEDMAN

This map is for the purpose of
locating a water right only
and has no intent to provide
legal dimensions or the location
of property lines.

ESTES SURVEYS, LLC
 PQ Box 17519 60382 Arnold Rd
 Salem, OR 97305-7519 Bend, OR 97702
 (503) 565-7593 (541) 382-7381