


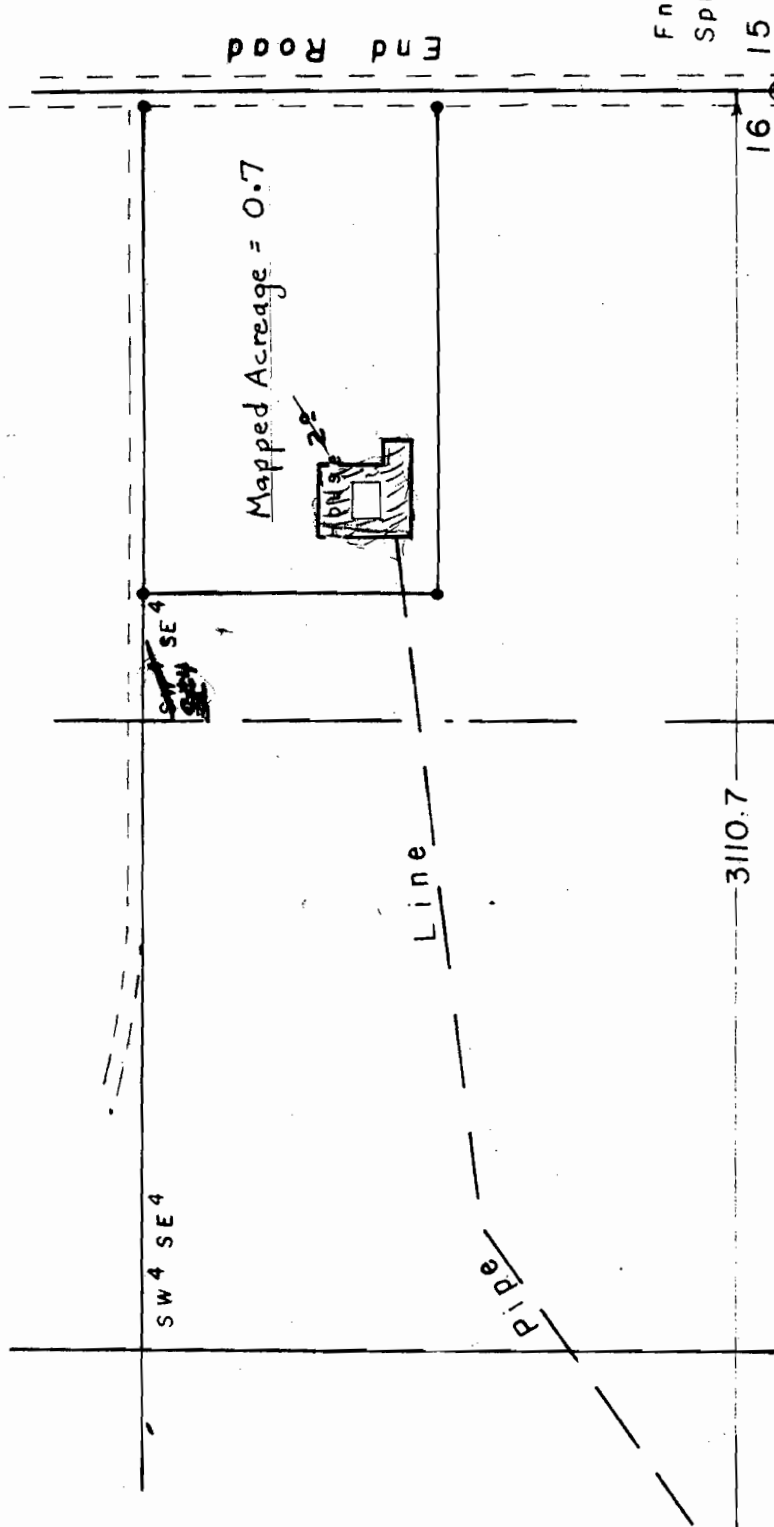

3/21/91

RECEIVED
 DEC - 81976
 WATER RESOURCES DEPT
 SALEM, OREGON


End. Bridge
 Spike & BT

Final Proof Map: App S-55017
 Per S-41273

Scale: 1" = 400'

Application No. 55017
 Permit No. 41273

Name of Joseph and Cathy Petrussek
 Inspection Survey March 21, 1991, by K. Kemp
 Map Prepared from Application Map
 by M. Mattick, May 7, 2003

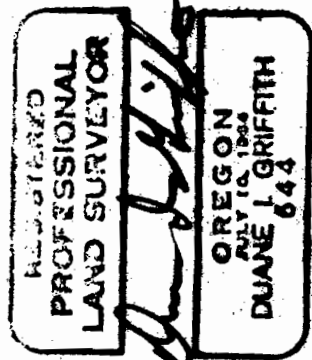

BAGETT, GRIFFITH & ASSOCIATES
 La Grande, Oregon

Map of Survey
 Spring Location for
 Water Right Application
 Section 16 T1S, R38E, WM
 UNION COUNTY, OREGON

SURVEYED FOR Joe Petrussek