
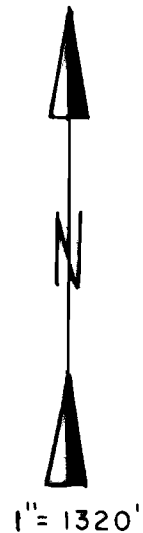


T. 15 S., R. 15 E., W.M.

LITTLE
HUSTON
LAKE

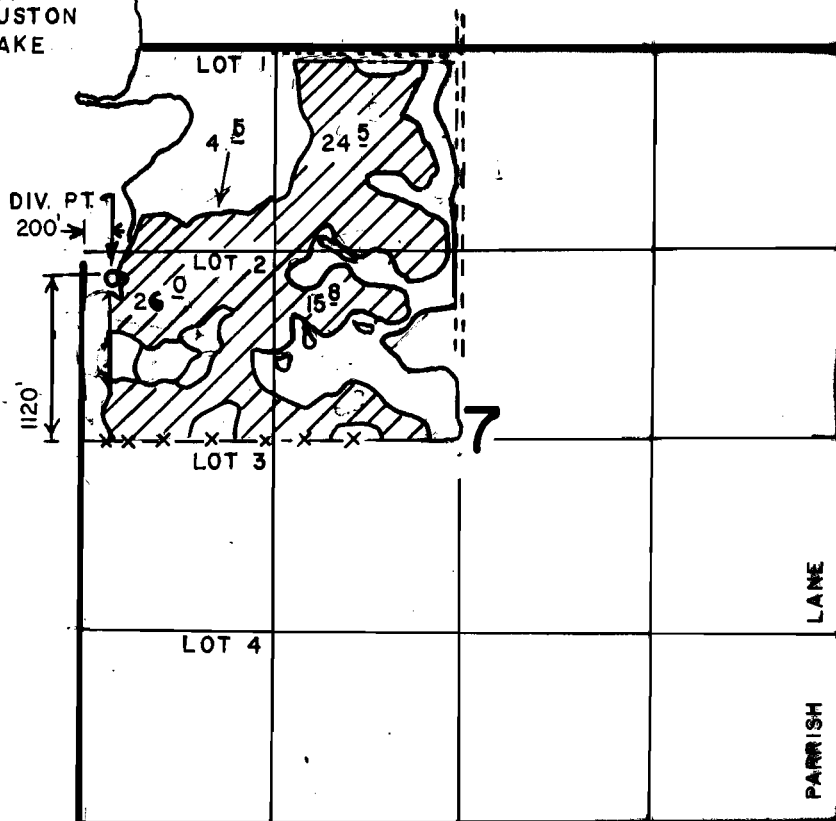

SUPPLEMENTAL IRRIGATION

FINAL PROOF SURVEY UNDER

Application No. 57104... Permit No. 43876...
IN NAME OF

LEO L. LEONARD

Surveyed FEB. 16 1990, by B.W. BISHOP...

2-20-07 JWG
4-16-90 DSM
41013-180-220R