


T. 38 S., R. 11 1/2 E., W.M.

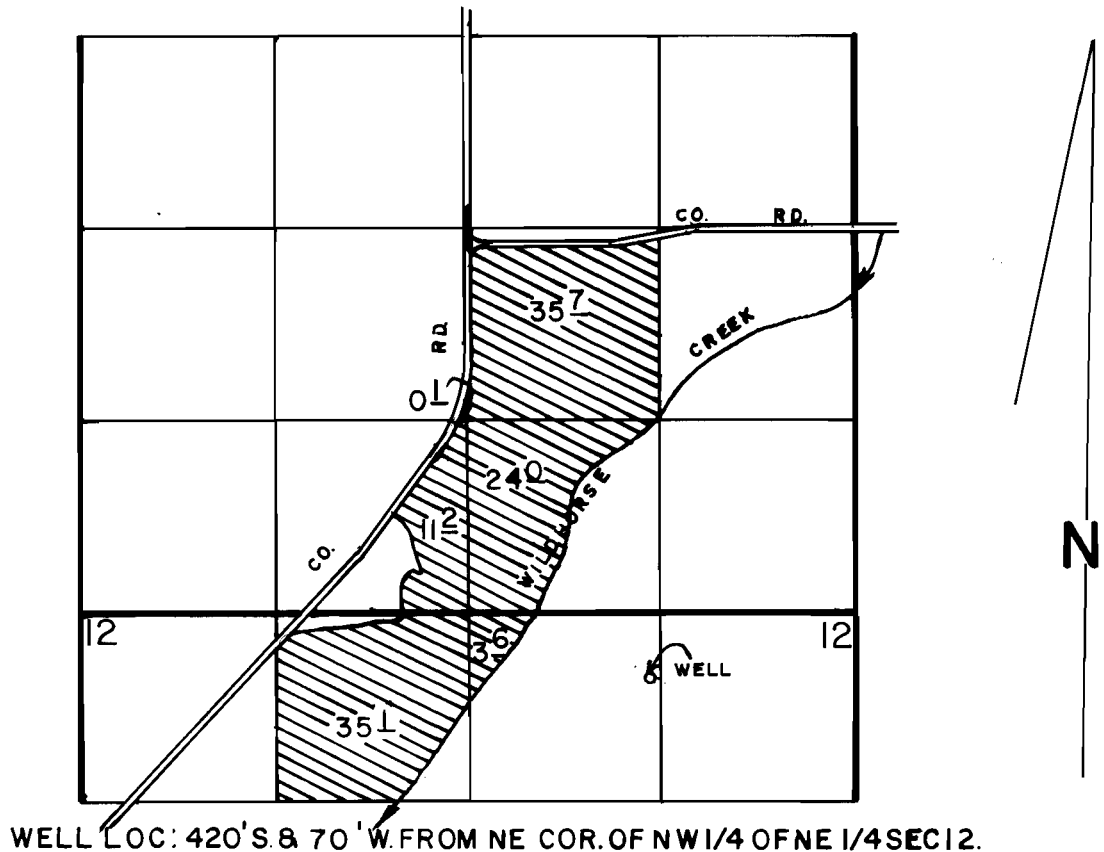

SCALE: 1" = 1320'

FINAL PROOF SURVEY
UNDER

Application No. G-9811 Permit No. G-8991
IN NAME OF

GRANT F. BROWN

Surveyed FEB 26, 1992, by DEL SPARKS