


T. 1 S., R. 3 W., W.M.

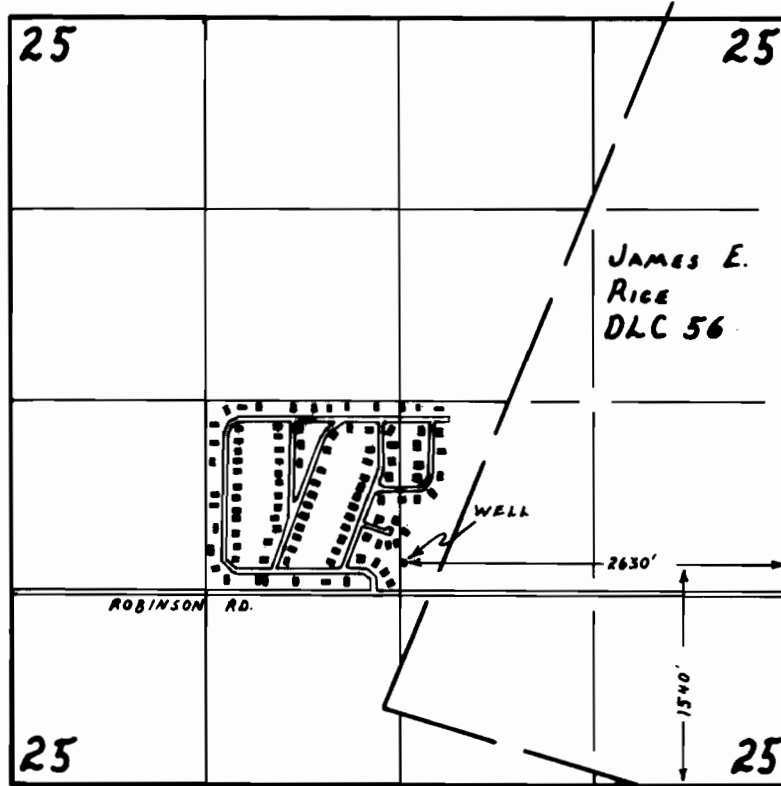

FINAL PROOF SURVEY

UNDER

Application No. G-5682 Permit No. G-7812
IN NAME OF

SOUTH HILLS WATER SYSTEM

Surveyed July 14, 1993, by R.W. Klassen