


T. 32 S., R. 6 W., W. M.

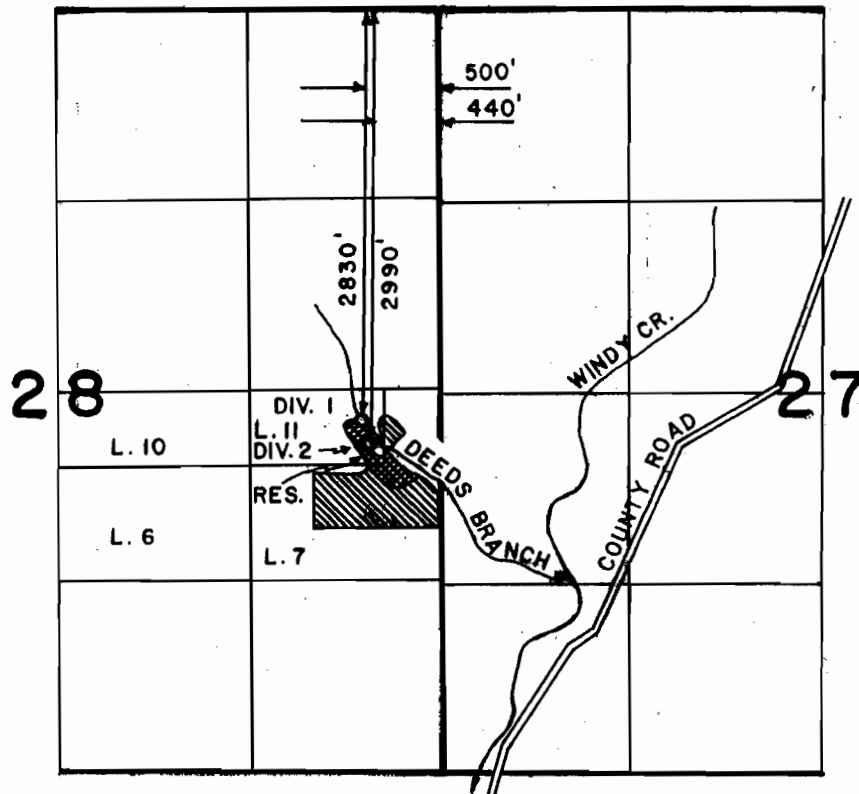

SCALE: 4" = 1 MILE

FINAL PROOF SURVEY
UNDER

TRANSFERS 4586 & 4587

R-59353

R-8202

Application No. 59354. Permit No. 45317

IN NAME OF

DOUGLAS E. KIRKLAND

Surveyed JUNE 6, 1987, by J.M. SCHMORDE

IRRIGATION ACREAGE

	PRIM.	SUPP.
L. 7	67	09
L. 11	01	01