


T. 2 N. R. 32 E. W.M.

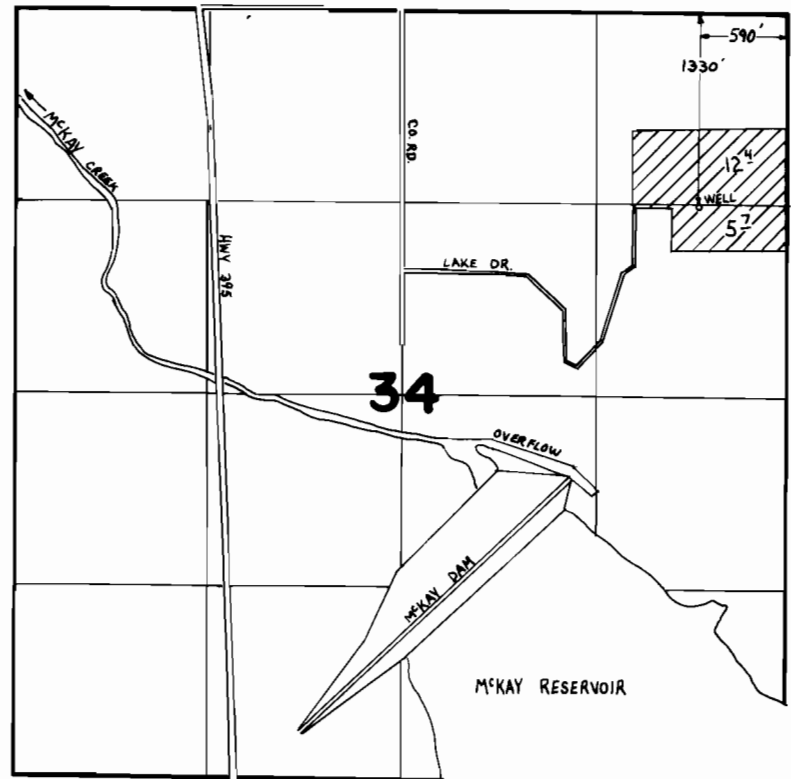

Scale 1" = 1320'



FINAL PROOF SURVEY UNDER

Application No. G10143. Permit No. G.9221.....
IN NAME OF

DANNY RAY & PERRIE KIM SMITH

Surveyed Nov. 13, 1986, by V. Church.....