


T. 15 S., R. 5 W., W.M.

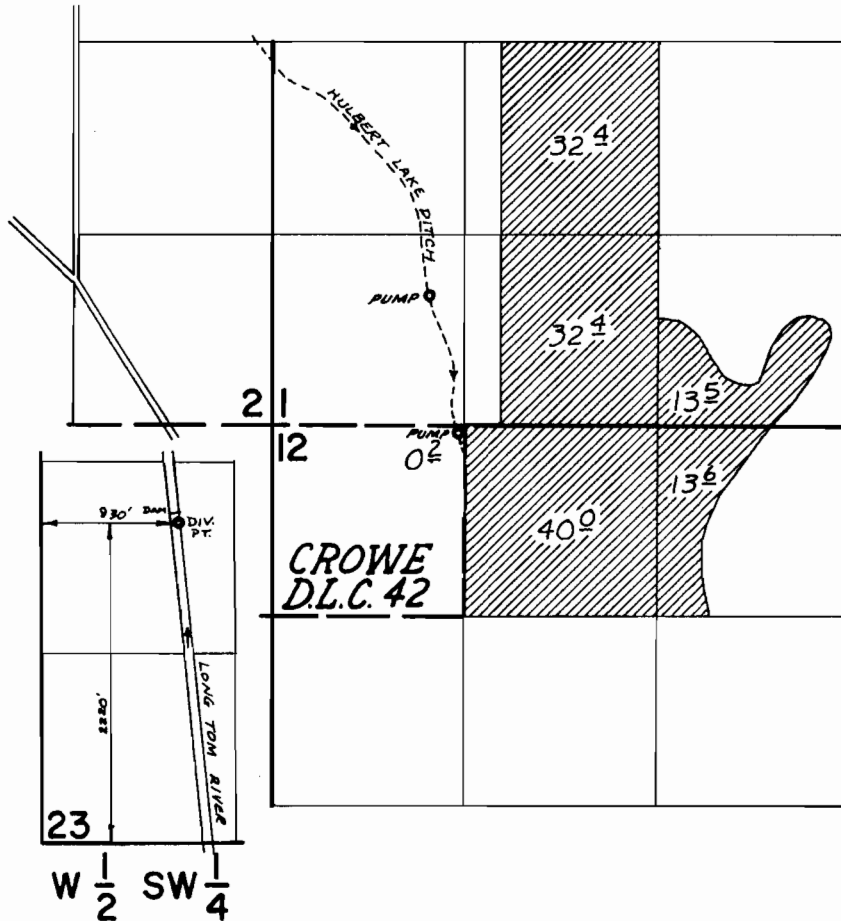

FINAL PROOF SURVEY
UNDER

Application No. 47201 Permit No. 35702
IN NAME OF

MRS. JESSIE TRACER PHILLIPS

Surveyed Sept 18 1973, by D. Noeby