


T 15 S, R 5 W, WM

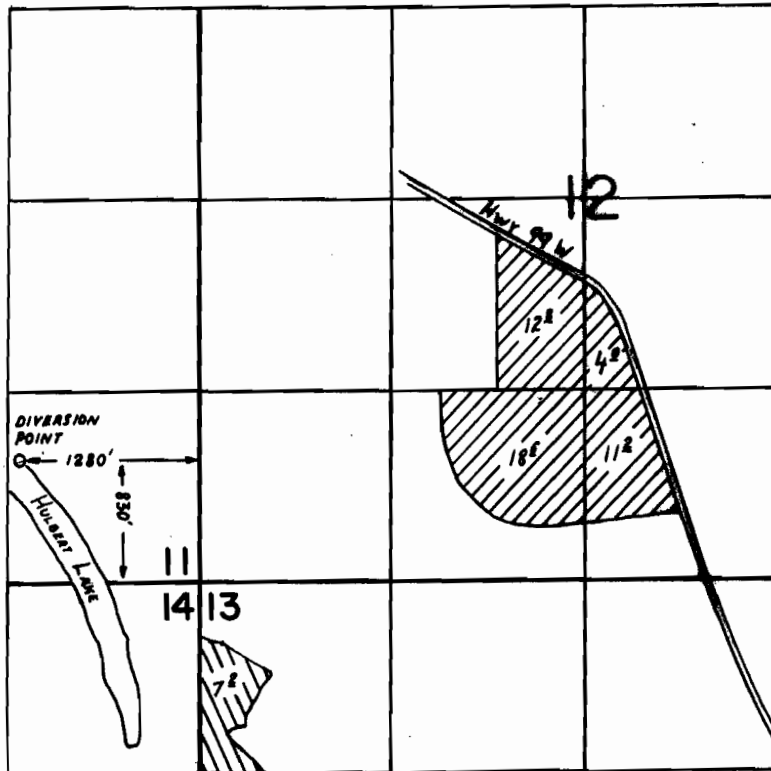

SCALE
1" = 1320'

FINAL PROOF SURVEY
UNDER



PRIMARY IRR.



PRIMARY w/
SUPPLEMENTAL IRR.

Transfer No.5649.....
Application No. Permit No.
IN NAME OF

.....GIBSON & GIBSON.....

Surveyed NOV....12.. 1987., by T.M....WARREN..

LHW 3/1/07

RWK