


T. 15 S. R. 5 W. W. M.

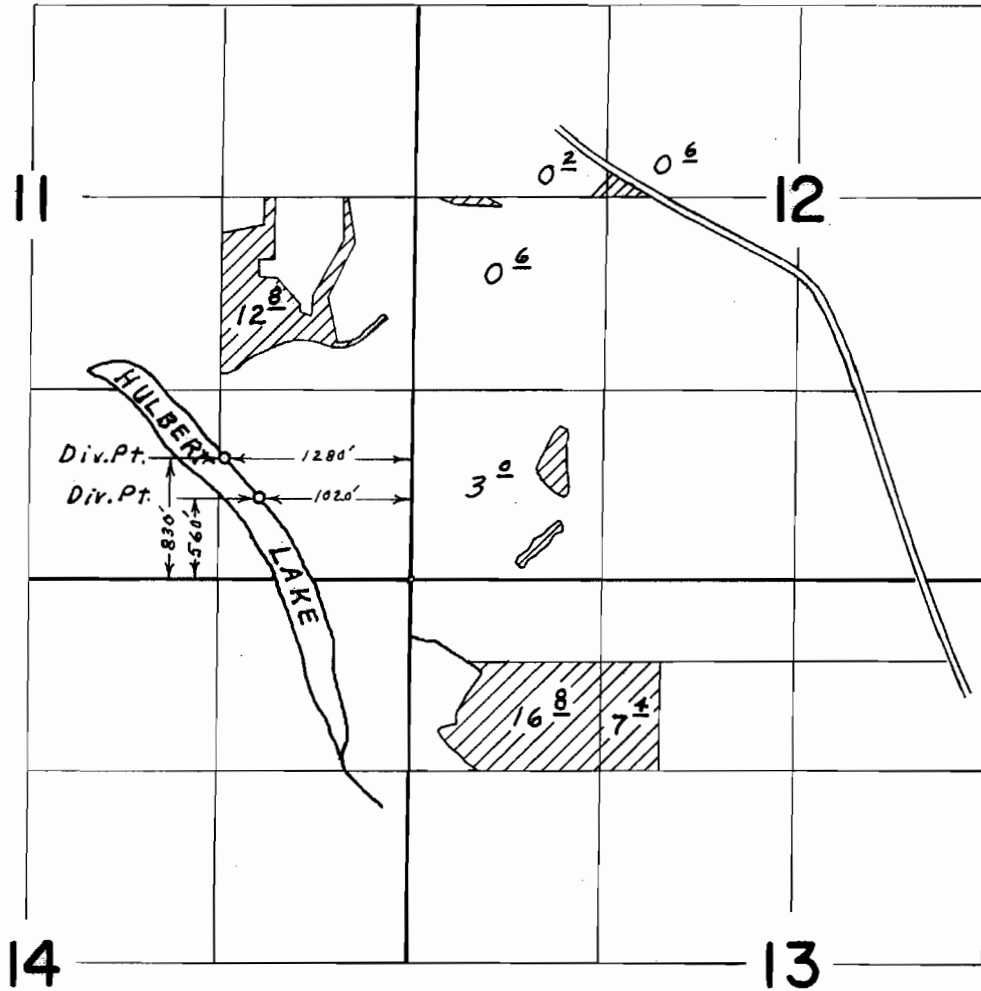

FINAL PROOF SURVEY
UNDER

Application No. 44561 Permit No. 33353

IN NAME OF

HOWARD & GLADYS GIBSON

Surveyed June 5, 1970, by L. E. Gould