


T. 15 S. R. 5 W. W. M.

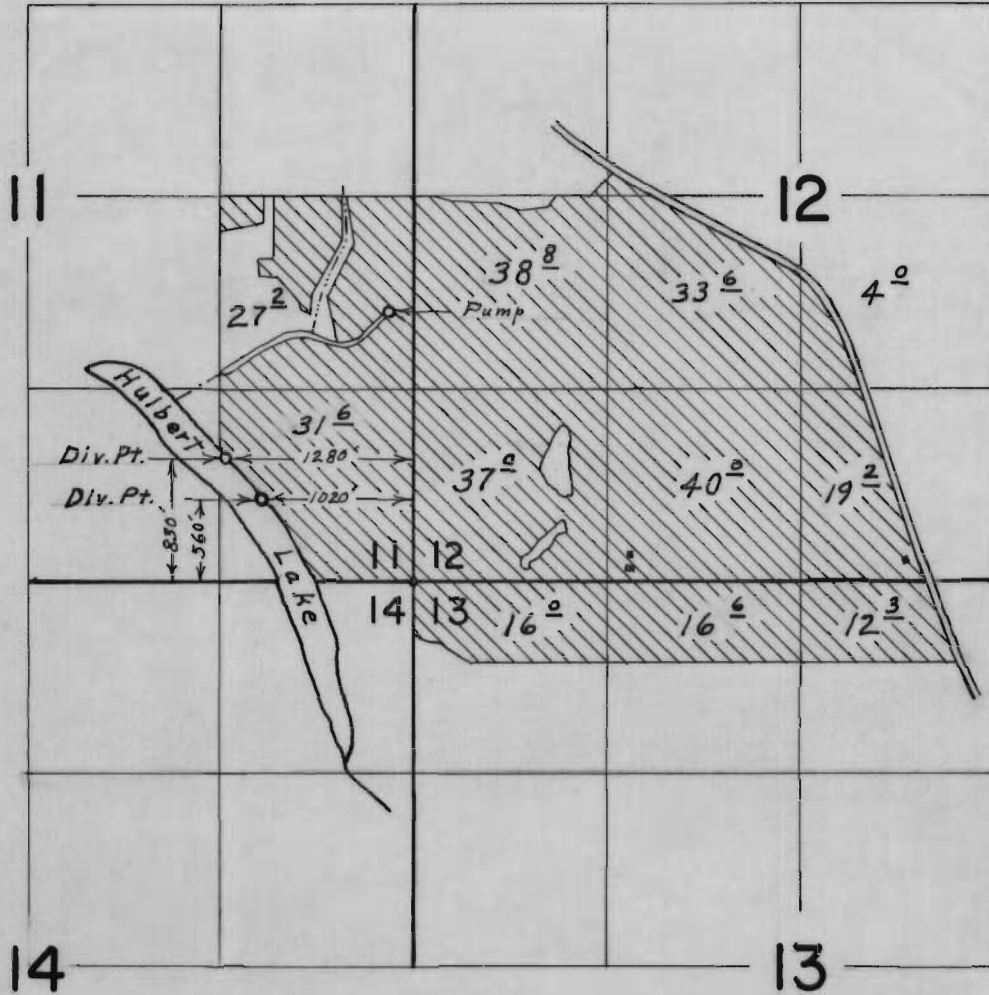

FINAL PROOF SURVEY
UNDER

Application No. 20732 21720 Permit No. 16231 17049
IN NAME OF

H. H. GIBSON & SON

Surveyed May 10, 1950, by H. L. COFFMAN