

FINAL PROOF MAP FOR GROUNDWATER RIGHTS

IN THE NAME OF


C.R. SOMMERS & M.K. SOMMERS

SE1/4 NE1/4 SEC. 22, T.36S., R.12E., W.M.

KLAMATH COUNTY, OREGON



SCALE: 1" = 400'

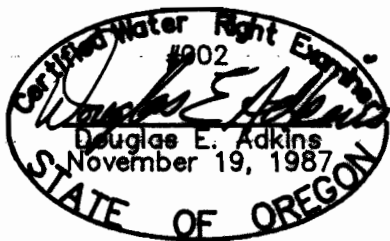

LAND IRRIGATED




ARTESIAN WELL



3/4" IRON PIPE

THIS MAP IS FOR THE PURPOSE OF
IDENTIFYING THE LOCATION OF THE
WATER RIGHT ONLY AND HAS NO
INTENT TO PROVIDE DIMENSIONS OR
LOCATION OF PROPERTY LINES.

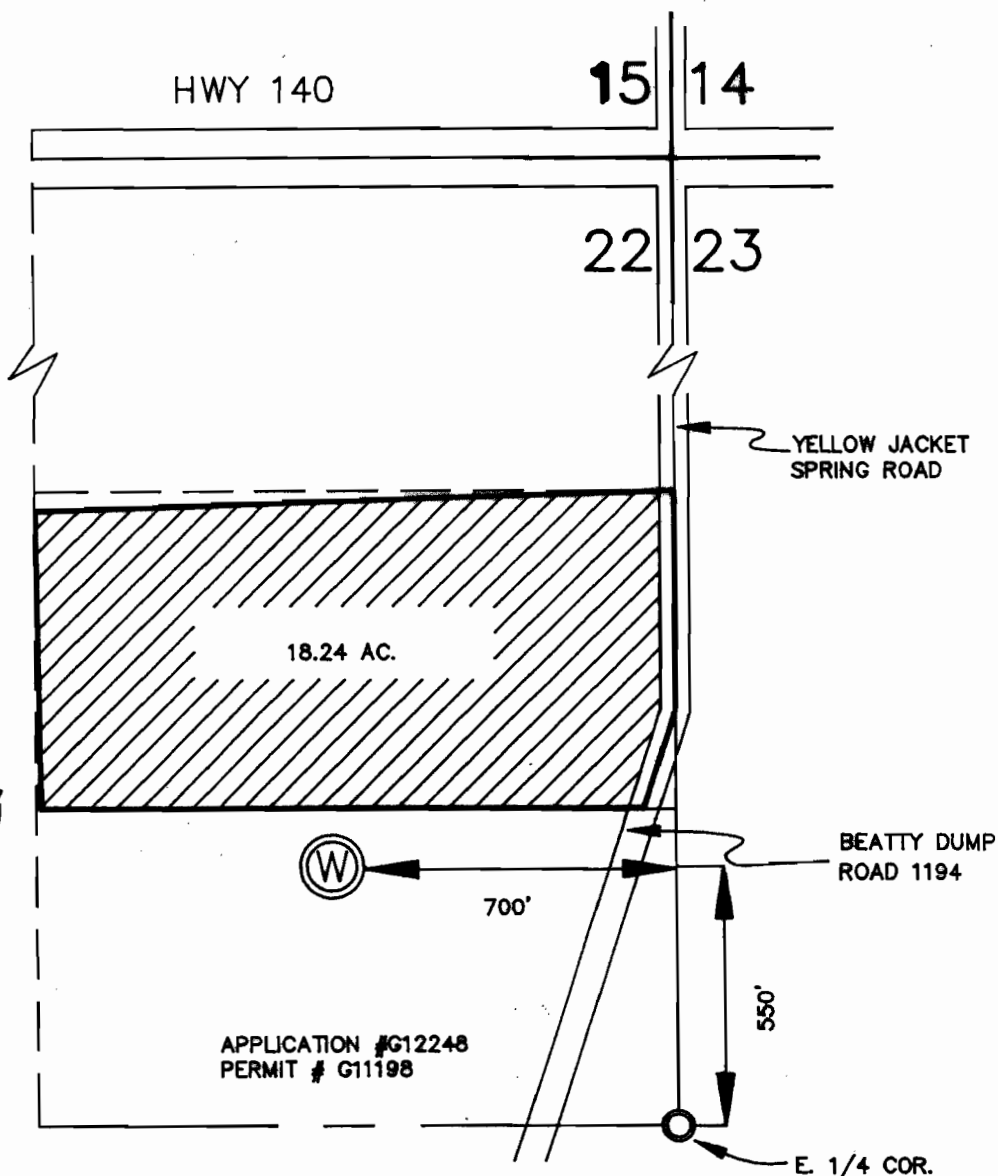

MAP PREPARED BY: **ADKINS CONSULTING ENGINEERS INC.**
1453 ESPLANADE AVE.
KLAMATH FALLS, OR. 97602
PHONE: (503) 884-4666

MARCH 1992

JOB No. 1320-01