




T. 8 S., R. 4 W., W.M.

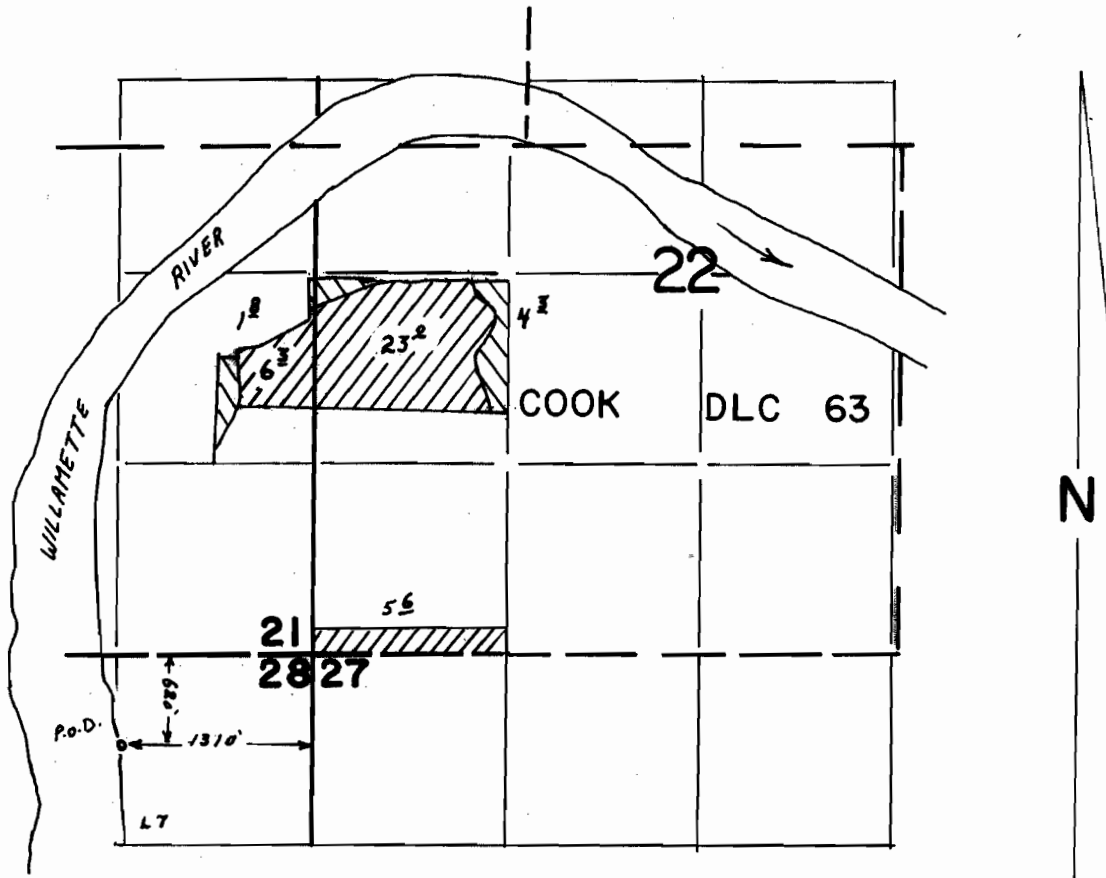

-  PRIMARY
-  SUPPLEMENTAL

SCALE 1" = 1320'
FINAL PROOF SURVEY
 UNDER

Application No. **69136** Permit No. **50043**
 IN NAME OF

SUN-RAY FARMS

Surveyed **AUG 3 1988**, by **Z. SALEH**

41053-178-20 R
 1-19-89 Z.F.S.