


T. 4N. R. 28 & 29E. W.M.

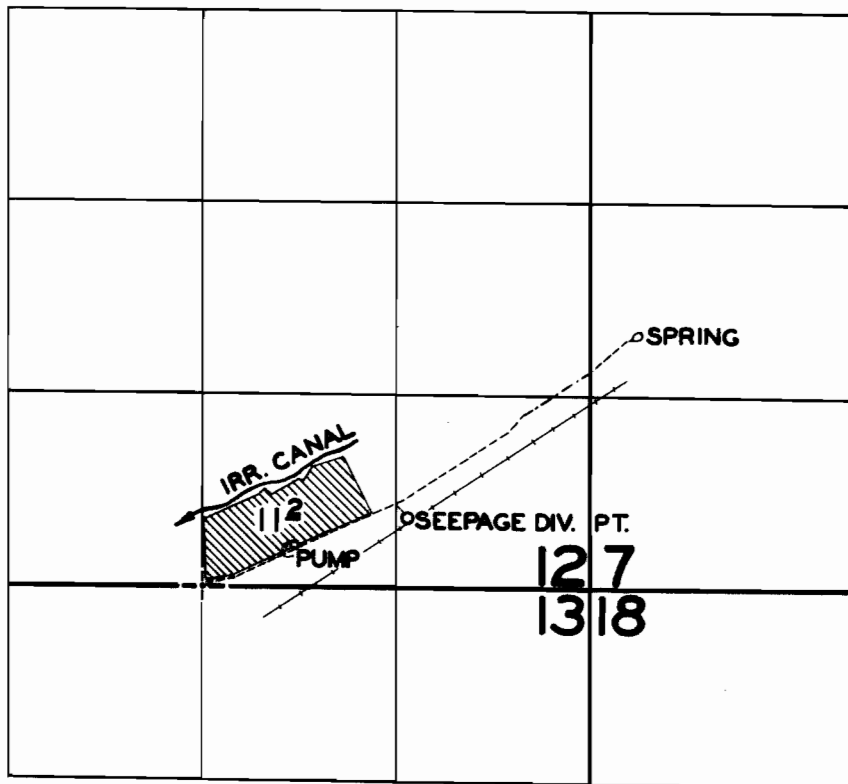

FINAL PROOF SURVEY

UNDER

Application No. 26051 Permit No. 20388

IN NAME OF

WILMER MOORE

Surveyed MAY 15 1957, by C.O. [Signature]