


# T.4N.R.28&29E.W.M.

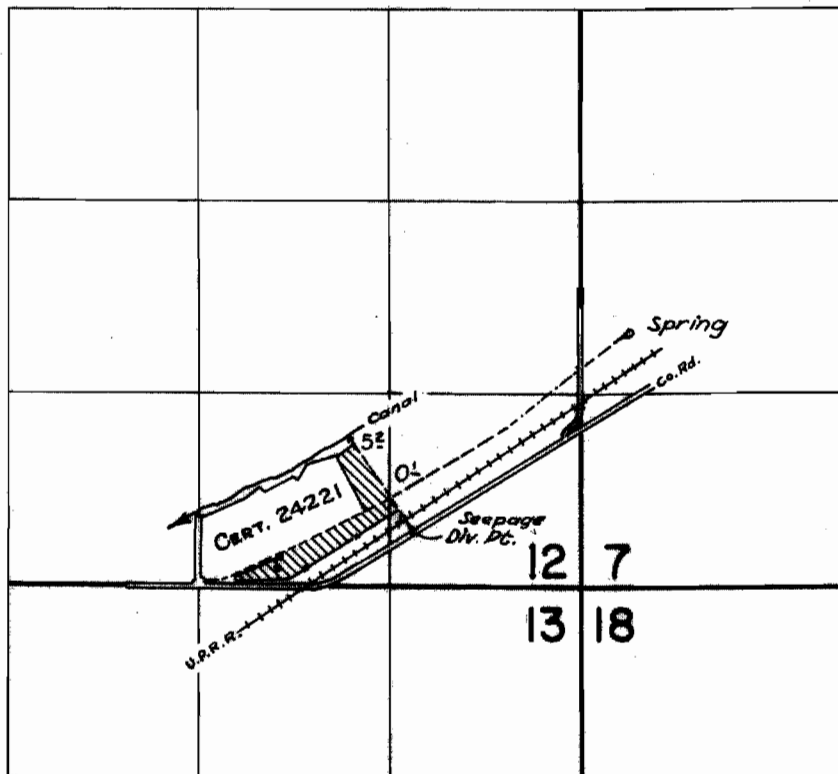

## FINAL PROOF SURVEY UNDER

Application No. **34008** Permit No. **26991**...  
IN NAME OF

**WILMER MOORE**

Surveyed June 9, 1962, by *Alpekson*