


T. 1 S. R. 13 E. W.M.

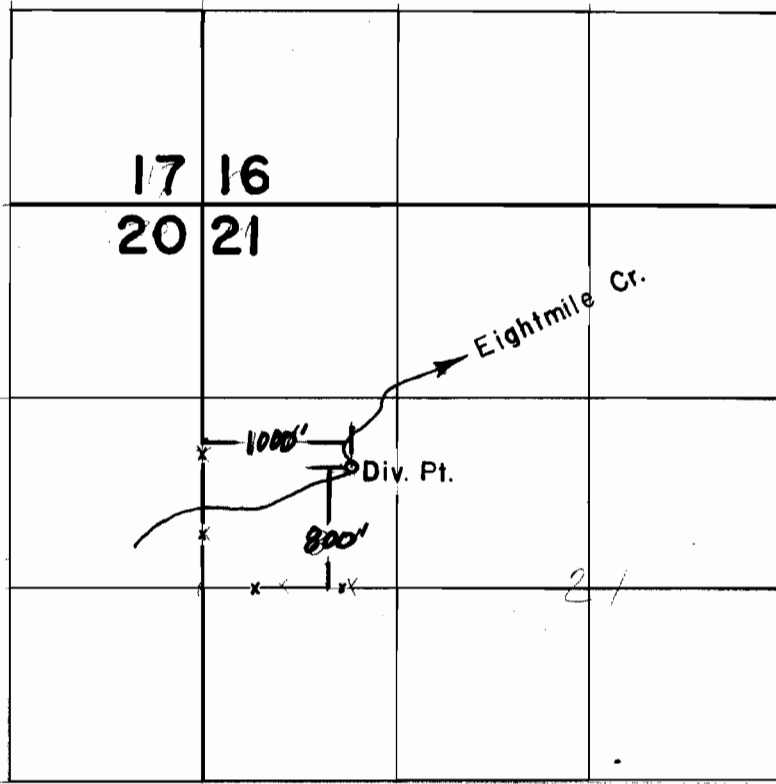

FINAL PROOF SURVEY  
UNDER

RECEIVED  
APR 14 1962  
STATE ENGINEER  

Application Transfer No. T-53 No. ....  
IN NAME OF

..... TED TIDWELL .....

Surveyed June 5, 1962, by *A. J. G. E. Housek*