


T. 1 S. R. 13 E. W.M.

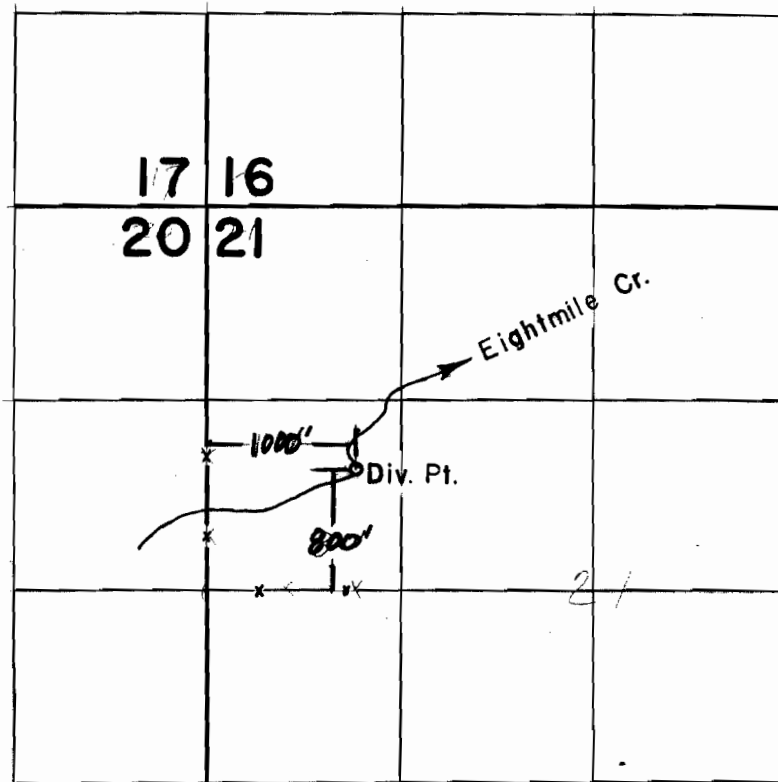

FINAL PROOF SURVEY
UNDER

RECEIVED
DEC 7 1967
STATE ENGINEER

Application Transfer No. T-53 No. _____
IN NAME OF

TED TIDWELL

Surveyed June 5, 1962, by *L. U. Jelousek*

Dom 1925
Dom 1928

4.41-1880

~~0.83-1880~~ ~~0.32-1880~~


2-1883
2-1883
11.3-1861
126

4.3-1881
33

6-1883

100

25 A. of property

14.28-1885
159

14-1885

292
19-1883

20
17
3

152-1885
232
Waterman Fish

Creeks sketched where running thru or bound by irrigated lands

2.7-1900

17-1891

7 7 7
7 7 7
Ditch

4.5-1884
6-1900
7-1923

22.8

34
Waterman Fish

Spring
8 Spring
22-1960

21

22

Dom

2

