

T.33S. R.15 W. W.M.


FINAL PROOF SURVEY, PERMIT 50829

APPLICATION 70130

SURVEYED BY: JOHN P. PRAHAR, CWRE #107, 1045 BALTIMORE #1, BANDON, OR 97411

SURVEYED JANUARY 18, 1993

33|34
4|3

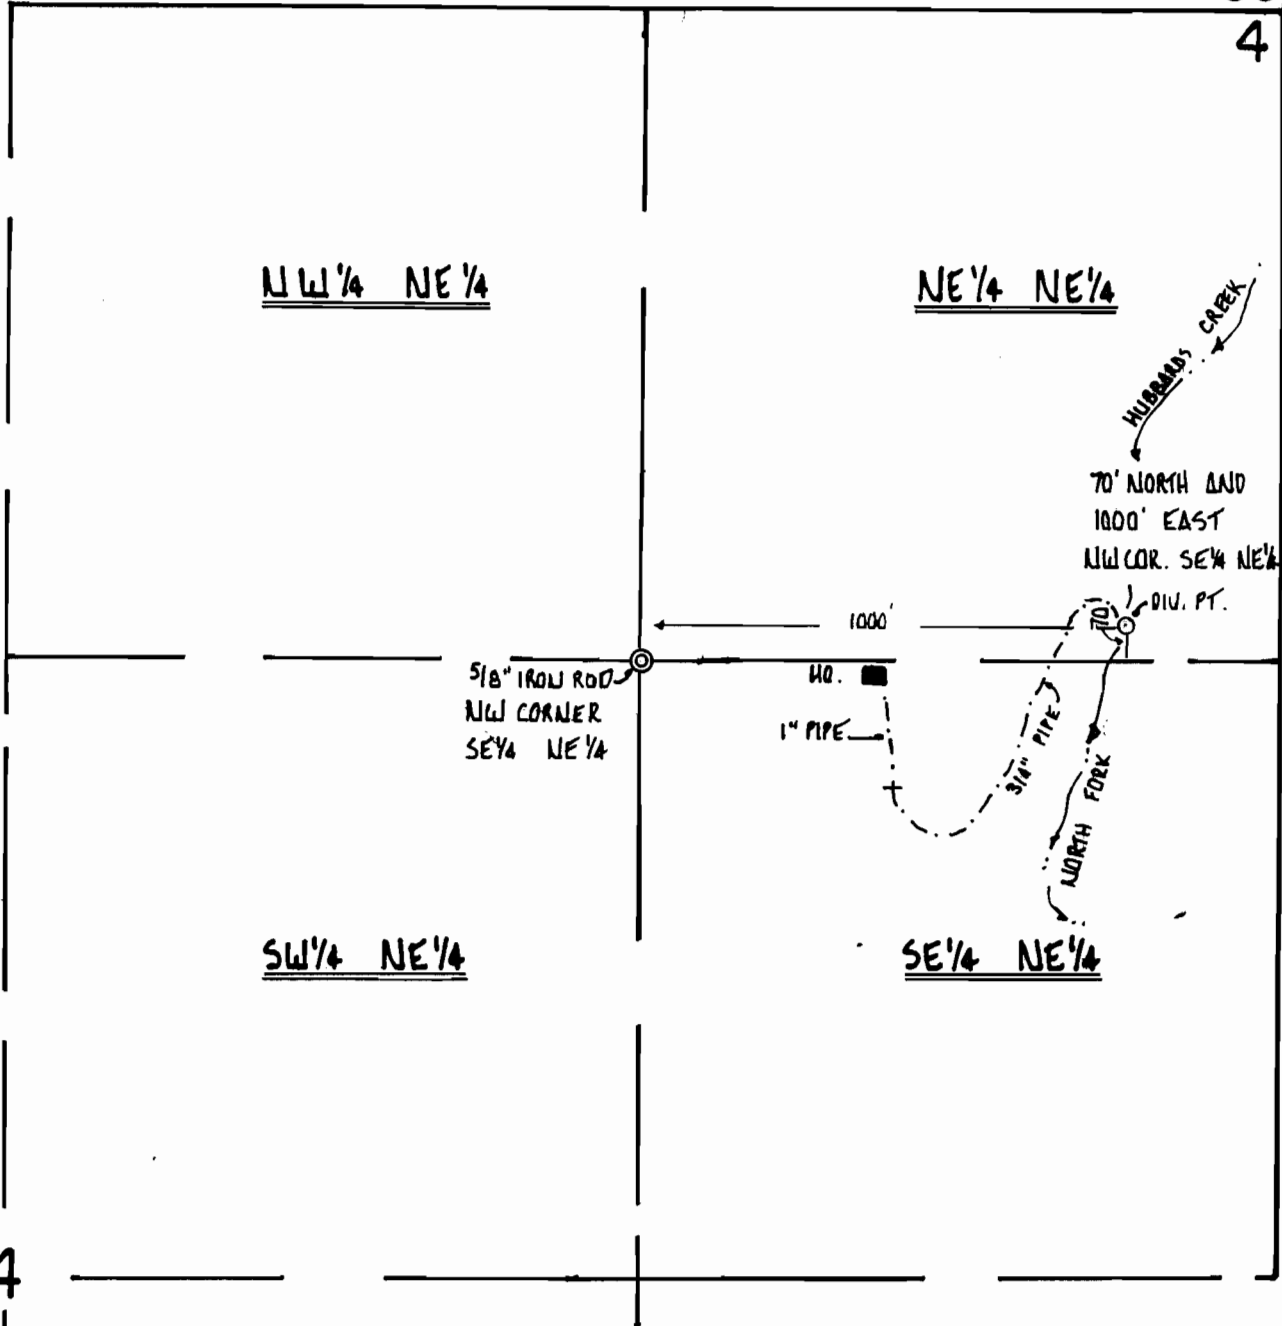

1" = 400'

IN NAME OF: ROBERT HARDY SR.

DISCLAIMER: THIS MAP WAS PREPARED FOR THE SOLE PURPOSE OF LOCATING A WATER RIGHT AND IS NOT INTENDED TO GIVE LEGAL DIMENSIONS OR SHOW PROPERTY OWNERSHIP LINES.

