


T.10S., R.3W.& 4W., W.M.

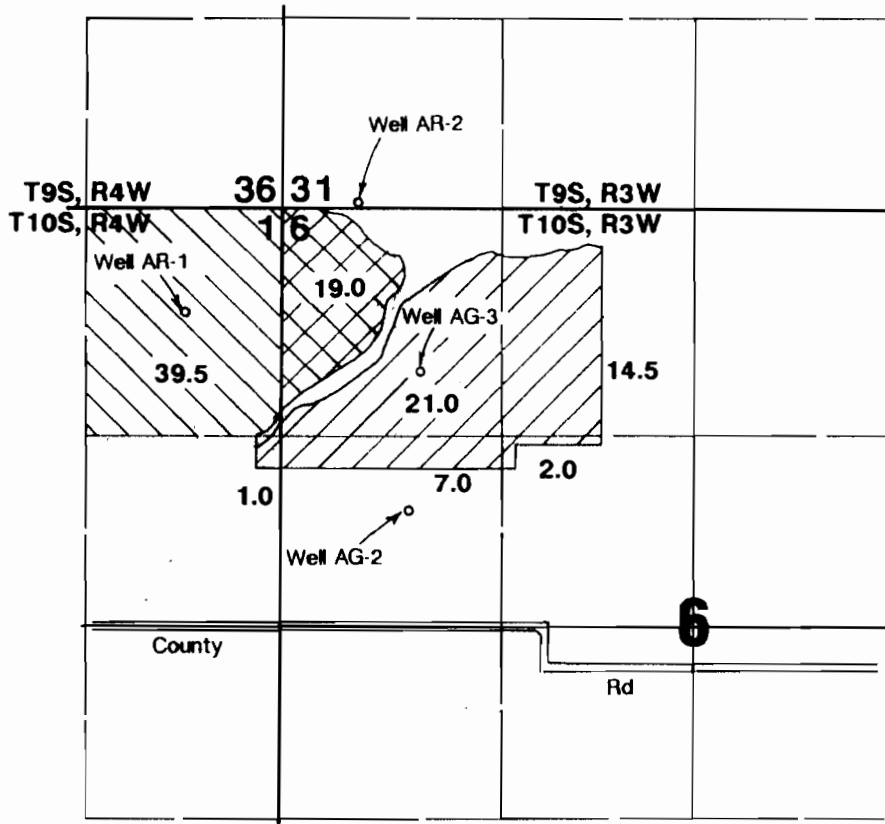

Area Irrigated



Well AR-1




Well AR-2



Wells AG-2 & AG-3

Well AR-1 located 725'S & 660'W from NE corner Section 1.
 Well AR-2 located 20'N & 500'E from NW corner Section 6.
 Well AG-2 located 800'N & 1950'W from center Section 6.
 Well AG-3 located 1125'S & 950'E from NW corner Section 6.

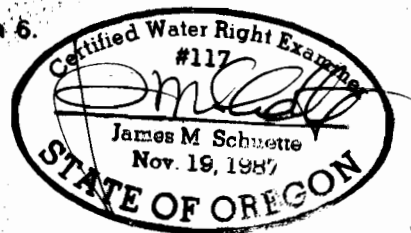

Final Proof Survey

Application #G-12313 Permit #G-11475

In Name Of

Elmer Cook

Surveyed on April 19, 1993 by JM Schuette

RECEIVED

MAY 13 1993

WATER RESOURCES DEPT
 SALEM, OREGON

THIS MAP WAS PREPARED FOR THE PURPOSE OF IDENTIFYING THE LOCATION OF A WATER RIGHT ONLY AND IS NOT INTENDED TO PROVIDE LEGAL DIMENSIONS OR LOCATION OF PROPERTY OWNERSHIP LINES.