

T4N R1W, T4N R2W, T5N R1W, T5N R2W, W.M. COLUMBIA COUNTY, OREGON

PREPARATION OF THIS MAP IS FOR THE PURPOSE OF IDENTIFYING THE LOCATION OF THE WATER RIGHT ONLY. THERE IS NO INTENT TO PROVIDE DIMENSIONS OR LOCATION OF PROPERTY OWNERSHIP LINES.

FINAL PROOF SURVEY

AND CLAIM OF BENEFICIAL USE UNDER

APPLICATION No. G-I4652, PERMIT No. G-I3537

IN THE NAME OF

THE HILAND WATER CORPORATION

FOR

QUASI-MUNICIPAL USE

FROM A WELL IN THE DART CREEK BASIN


SURVEYED DURING AUGUST 2003

BY JEFF DANIELSON, PLS, CWRE

SCALE: 1" = 1320'

NOTE:

WELL LOCATION (P.O.D.) IS S 60°58'16" E 185.5 FEET FROM THE P.O.B. OF SURVEY, THE W. QUARTER CORNER SECTION 25, T.5N., R.2W.

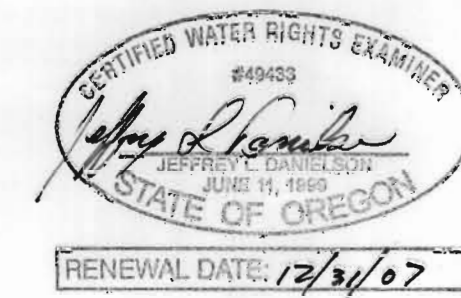

LEGEND

- P.O.U. BOUNDARY FOR G-I4652
- USGS GRID
- ROADWAY
- RAILWAY
- POWER LINE
- OPEN WATER
- WATER DISTRIBUTION
- ⊙ SECTION CORNER
- ⊕ 1/4 CORNER
- + 1/4-1/4 CORNER
- ⊙ MCNULTY WELL
- ⊙ HILAND WELL - P.O.D FOR G-I4652
- ⊙ GATE VALVE
- ⊙ PRESSURE REDUCTION VALVE
- ⊙ FIRE HYDRANT
- RESERVOIR

RECEIVED OCT 11 2006 WATER RESOURCES DEPT SALEM, OREGON	RECEIVED MAY 03 2006 WATER RESOURCES DEPT SALEM, OREGON
--	--

D L S	DANIELSON LAND SURVEYING, INC.	4050 TERRACE DR. NEWBERG, OR. 97132 (503) 538-5554
-------------	--------------------------------------	--

IN THE SECTIONS SHOWN OF
T4NR1W, T4NR2W, T5NR1W, T5N2W, W.M.
COLUMBIA COUNTY, OREGON.

SURVEYED FOR: HILAND WATER CORPORATION

SURVEYED BY: JEFF DANIELSON, PLS	AUGUST 2003
----------------------------------	----------------

SCALE: 1" = 1320'	DRAWN: CRW	04/22/06
-------------------	------------	----------

