


T. 1 S., R. 2 & 3 W., W.M.

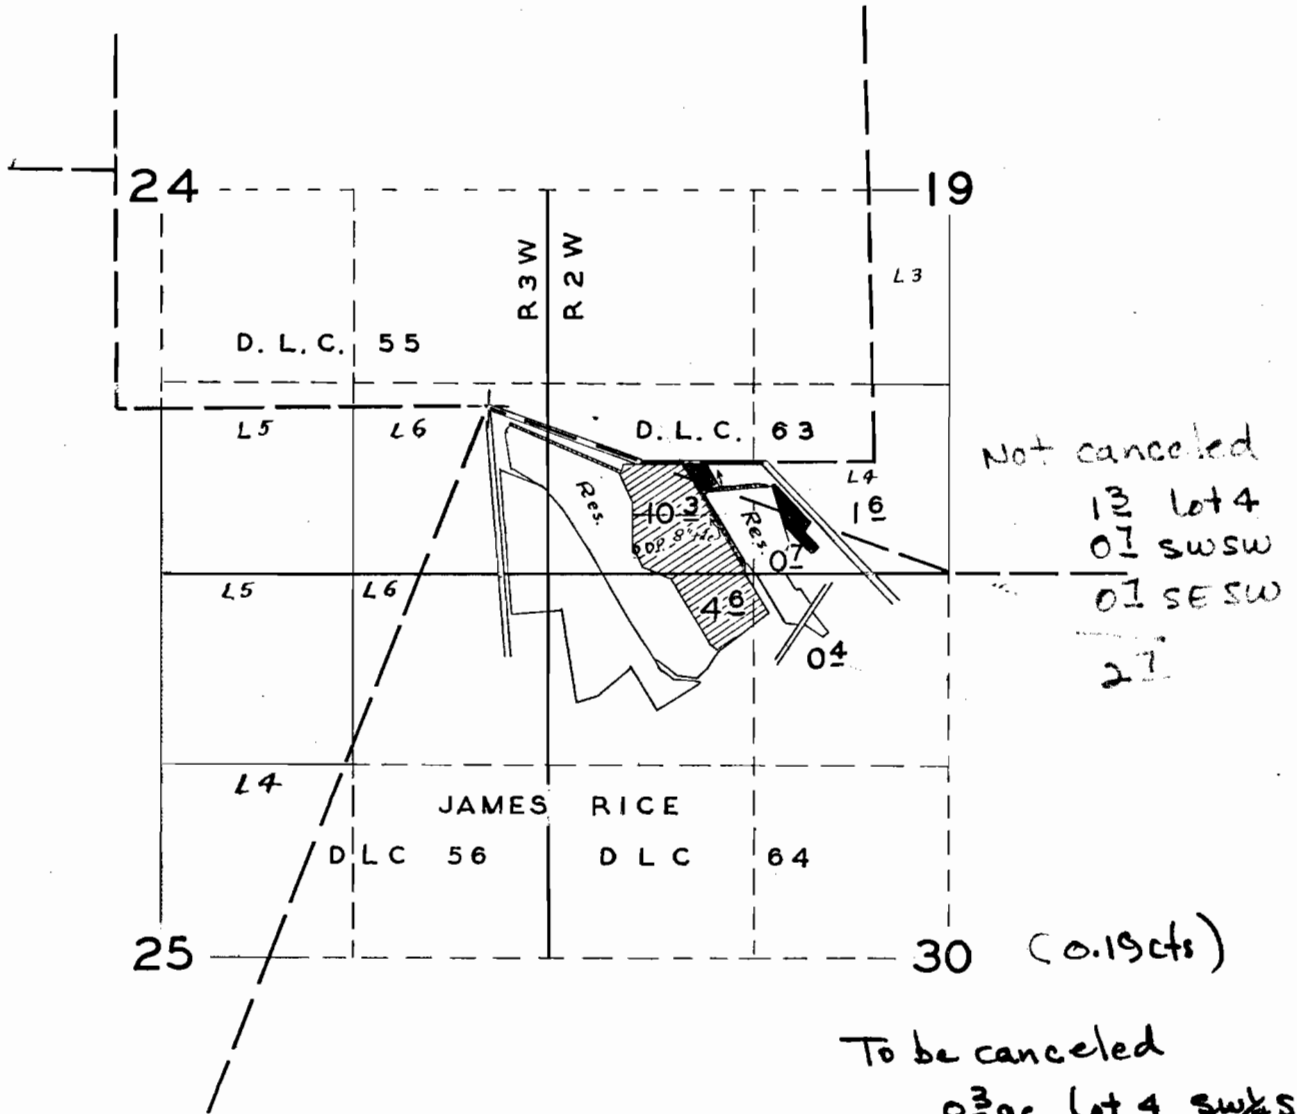

Not canceled  
 13 lot 4  
 0.7 ssw  
 0.1 se sw  
 2.1

To be canceled  
 0.3 ac lot 4 sw 1/4 sw 1/4  
 9.6 ac. sw 1/4 sw 1/4  
 w/in DLC 64  
 See 19  
 0.4 NE 1/4 NW 1/4  
 4.6 NW 1/4 NW 1/4  
 both w/in DLC 64  
 See 30

FINAL PROOF SURVEY

UNDER

R-25619

R-1205

Application No. 25962 Permit No. 20547

IN NAME OF

GEORGE & EDWIN E. BURKHALTER

Surveyed 4-25 1956, by M. BISH

T. 1 S., R. 2 W., W.M.