


T. 4 N., R. 1 W., W.M.

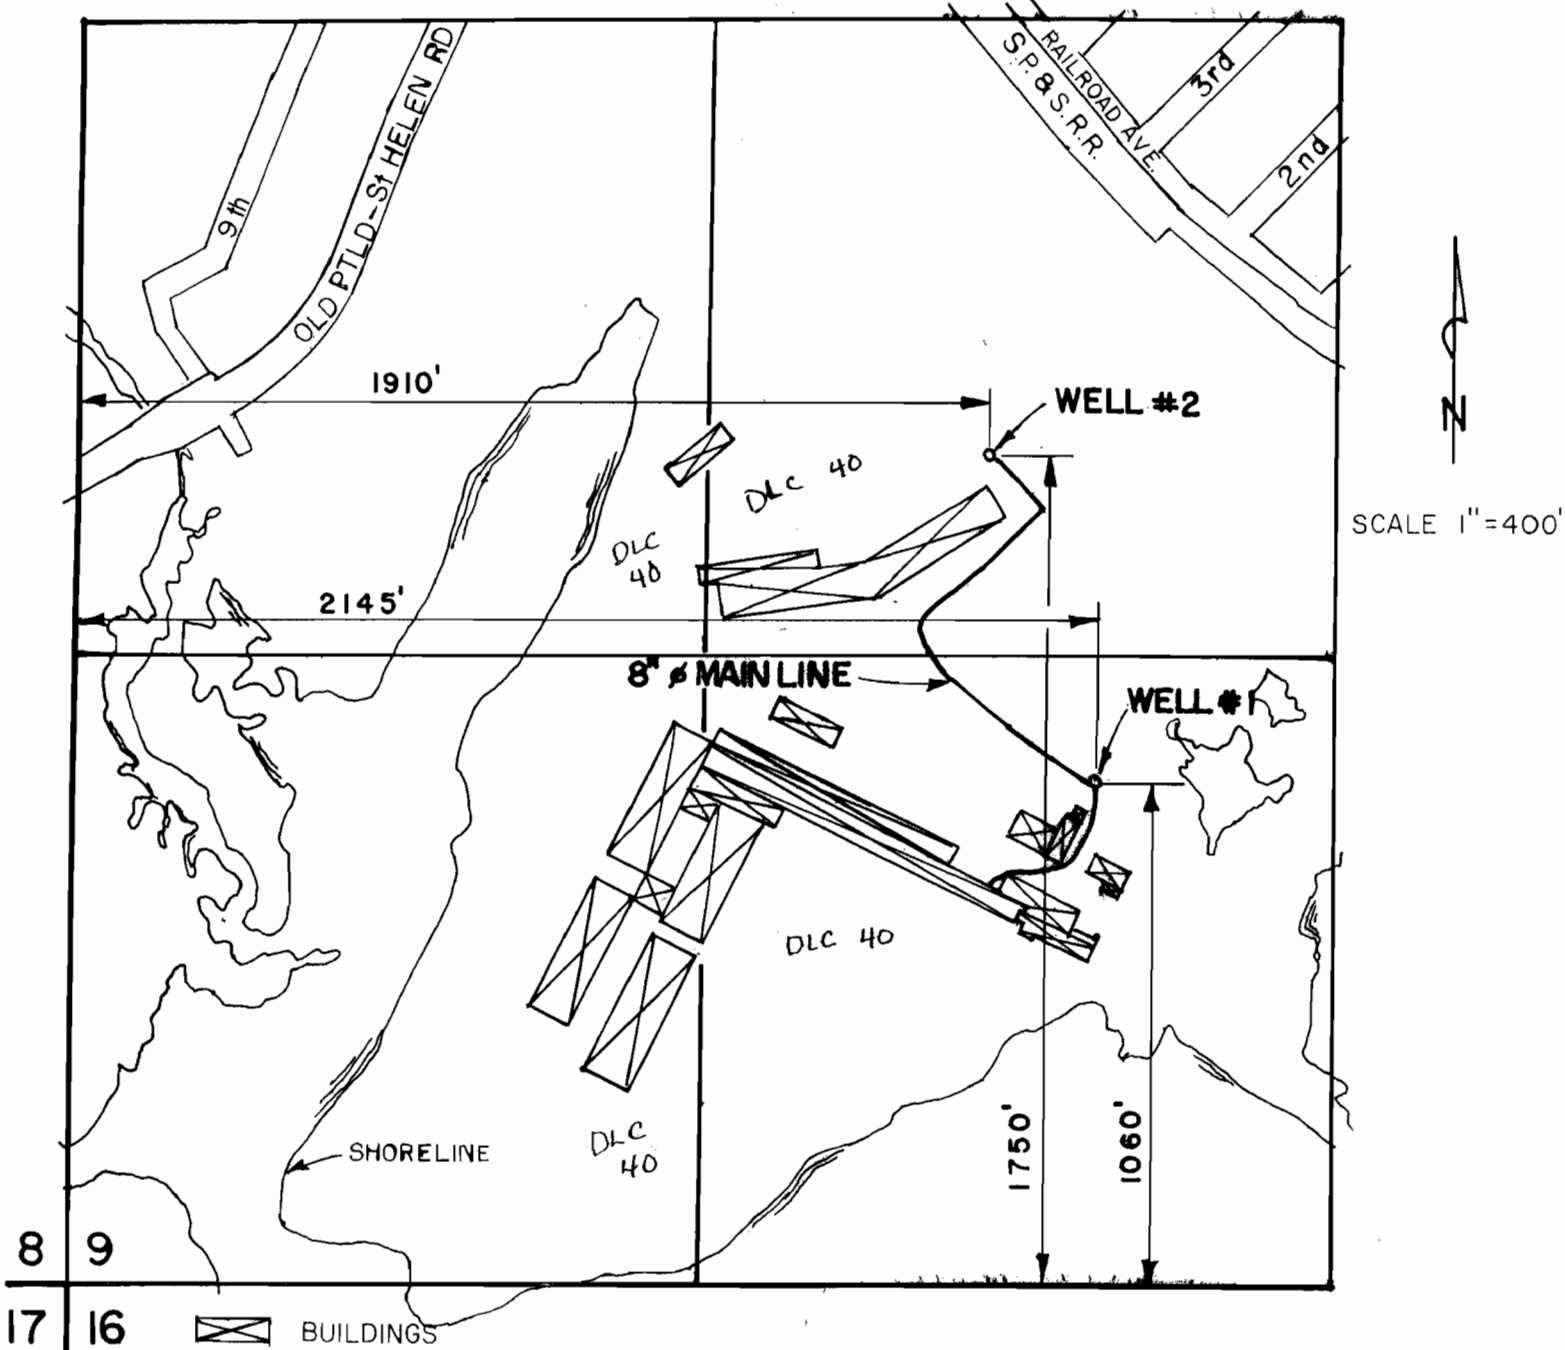

FINAL PROOF SURVEY  
UNDER

Application No. G-11897 Permit No. G-10892

IN NAME OF

ARMSTRONG WORLD INDUSTRIES

DLC 40 ADDED BY WRD Staff  
7/2/07  
Jug



RECEIVED

SEP 16 1990

The preparation of this map was for the purpose of identifying the location of water right only, and has no intent to provide dimensions or location of...

WATER RESOURCES  
SALEM, OREGON