


T. 4 N., R. 29 E., W. M.

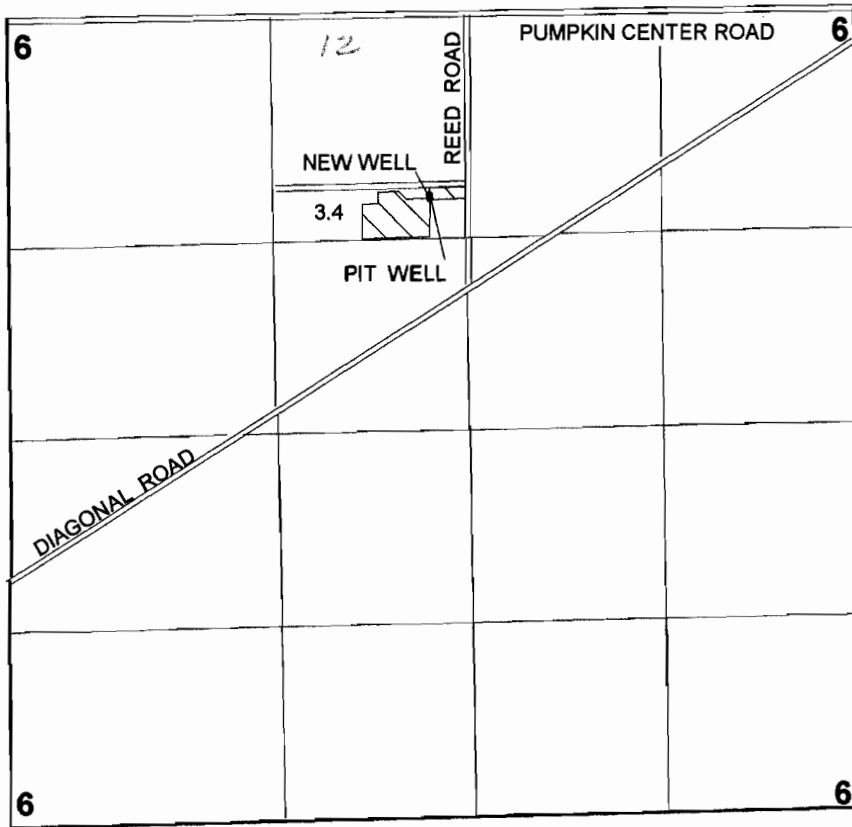

1" = 1320'

PIT WELL - 1265' SOUTH AND 265' WEST OF THE NORTH 1/4 CORNER, SECTION 6.

**FINAL PROOF SURVEY**  
UNDER  
Application No. G-11108 Permit No. G-10244  
IN THE NAME OF

-----  
Surveyed May 7, 2003 by: J. Miller