


T1N, R3W, WM

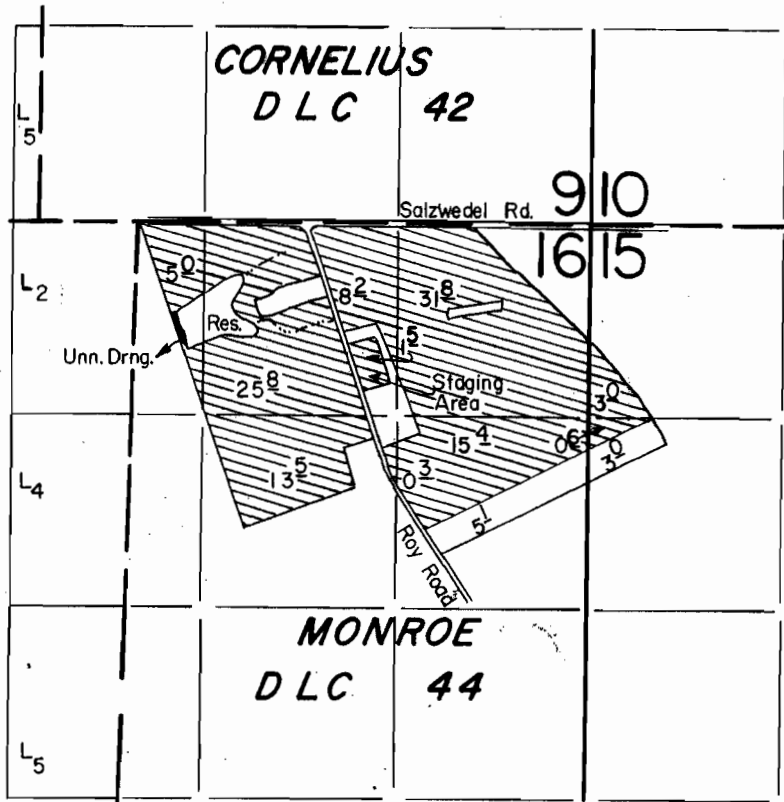

P.O.D. Loc.: 750' S. & 2820' W. from NE Cor. Sec. 16.

Scale : 1" = 1320'

### FINAL PROOF SURVEY UNDER

R-68405                      R-10889  
Application No. 68406.. Permit No. 50166.....

IN NAME OF  
**GLENN WALTERS NURSERY**

Surveyed JULY 10, 1989., by T. Warren.....