

# T. 6 S. R. 2 W. W.M. NORPAC BROOKS PLANT

IRRIGATION USE


WACONDA RD. L7 L8 0.6



N



4" = 1 MI.

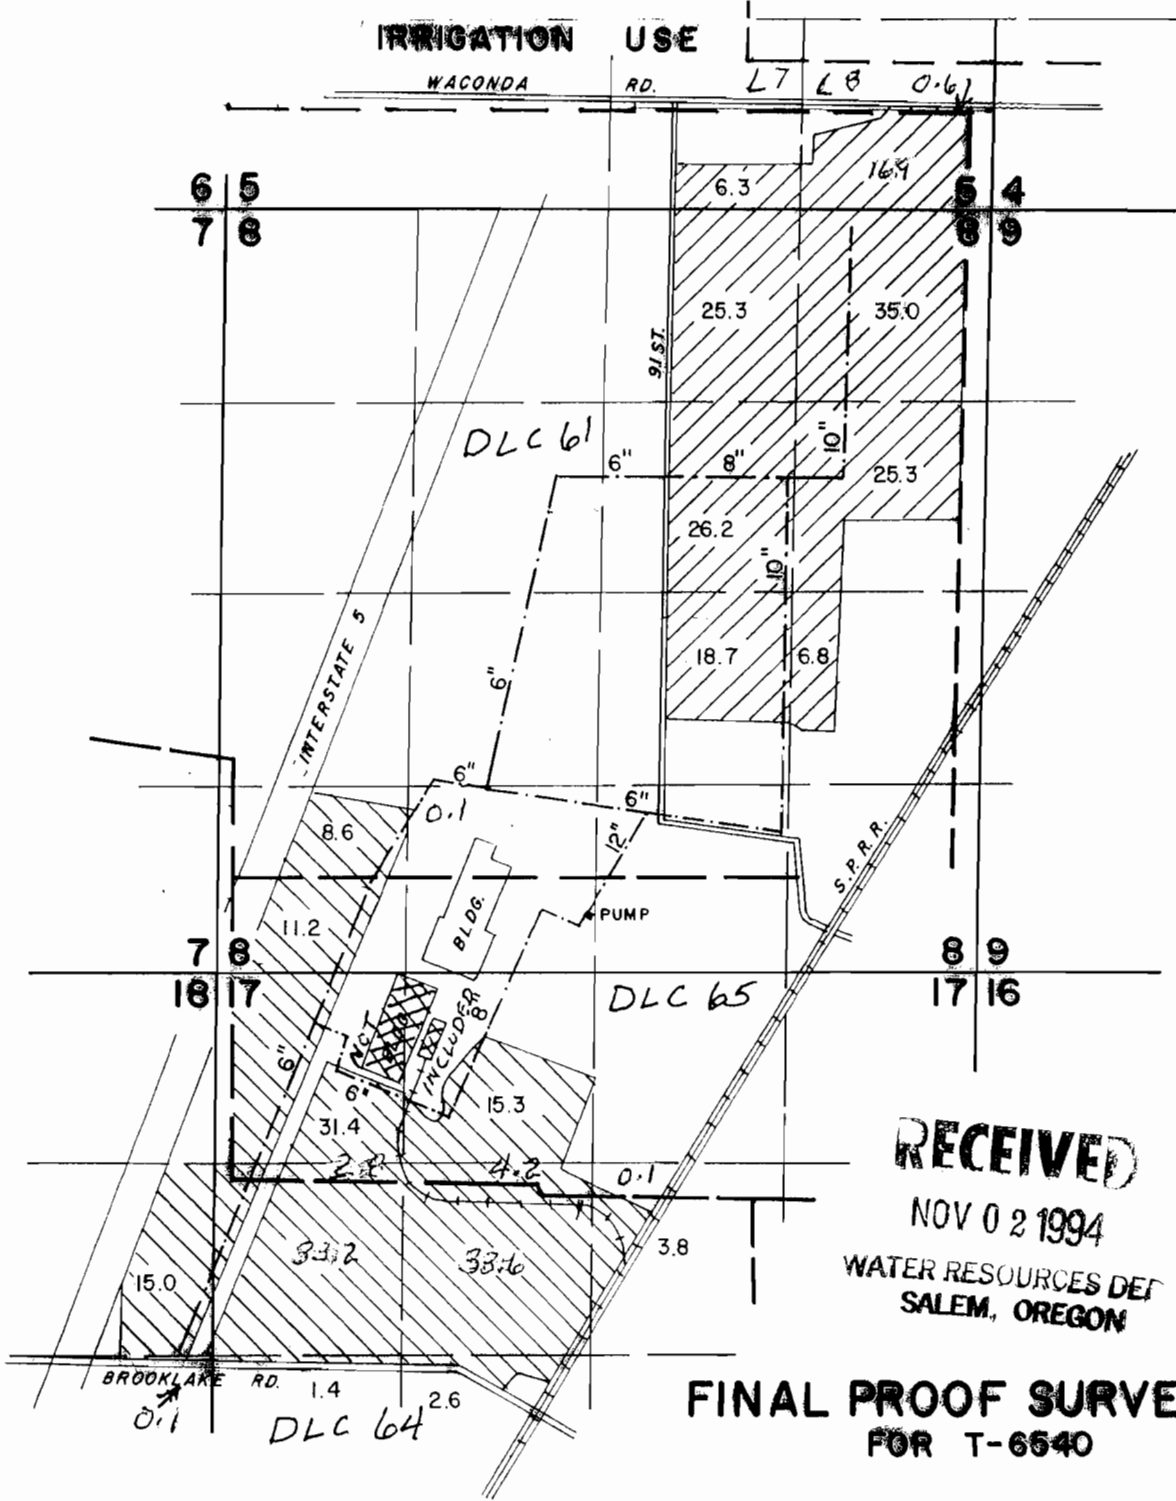

**RECEIVED**

NOV 02 1994

WATER RESOURCES DIV  
SALEM, OREGON

**FINAL PROOF SURVEY  
FOR T-6540**

BY:



THIS MAP WAS PREPARED FOR THE PURPOSE OF IDENTIFYING THE LOCATION OF A WATER RIGHT ONLY AND IS NOT INTENDED TO PROVIDE LEGAL DIMENSIONS OR LOCATION OF PROPERTY OWNERSHIP LINES.

AMENDED 4/12/07 LHN WRD