

# T. 6 S. R. 2 W. W.M. NORPAC BROOKS PLANT

IRRIGATION USE

WACONDA

RD.

L7

L8


0.6

6 5  
7 8

6 4  
8 9



4" = 1 MI.

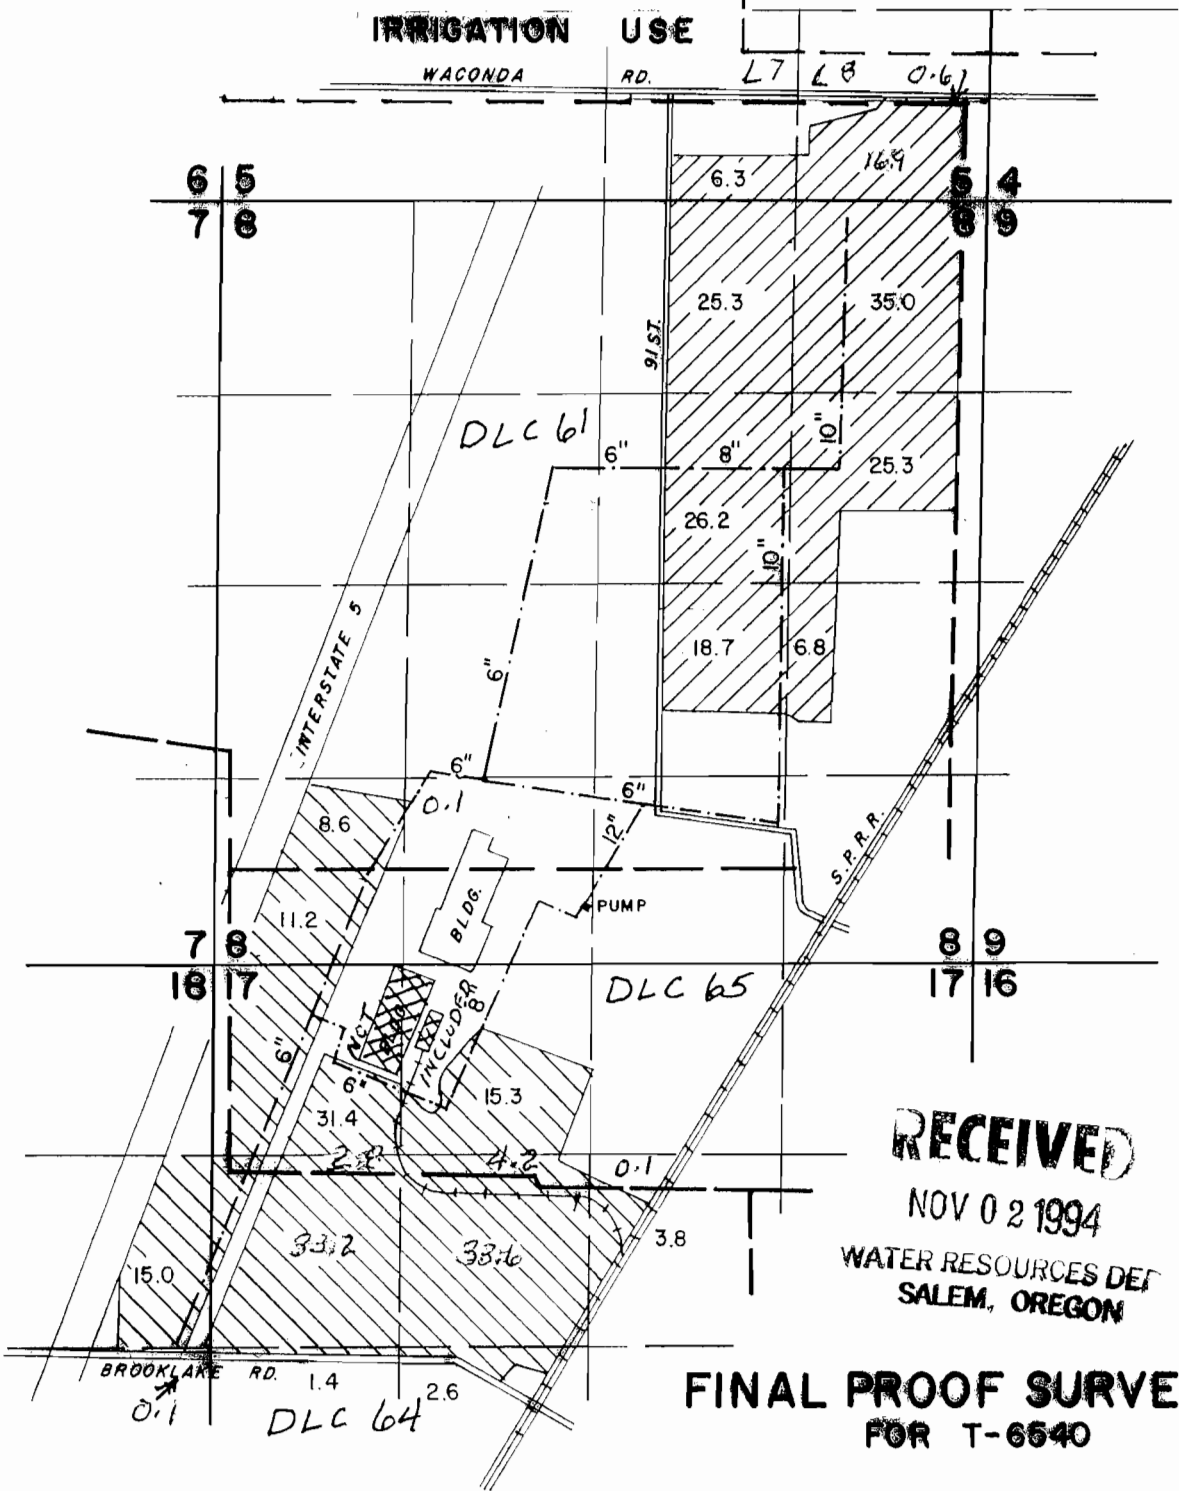


**RECEIVED**

NOV 02 1994

WATER RESOURCES DEPT  
SALEM, OREGON

**FINAL PROOF SURVEY  
FOR T-6540**

BY:

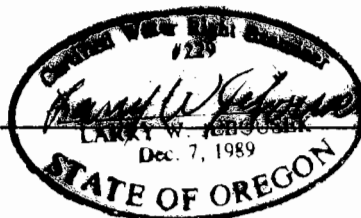

THIS MAP WAS PREPARED FOR THE PURPOSE OF IDENTIFYING THE LOCATION OF A WATER RIGHT ONLY AND IS NOT INTENDED TO PROVIDE LEGAL DIMENSIONS OR LOCATION OF PROPERTY OWNERSHIP LINES.

AMENDED 4/12/07 LHN WRD