

T. 6 S. R. 2 W. W.M. NORPAC BROOKS PLANT

IRRIGATION USE


WACONDA RD. L7 L8 0.67

6 5
7 8

5 4
8 9



4" = 1 MI.

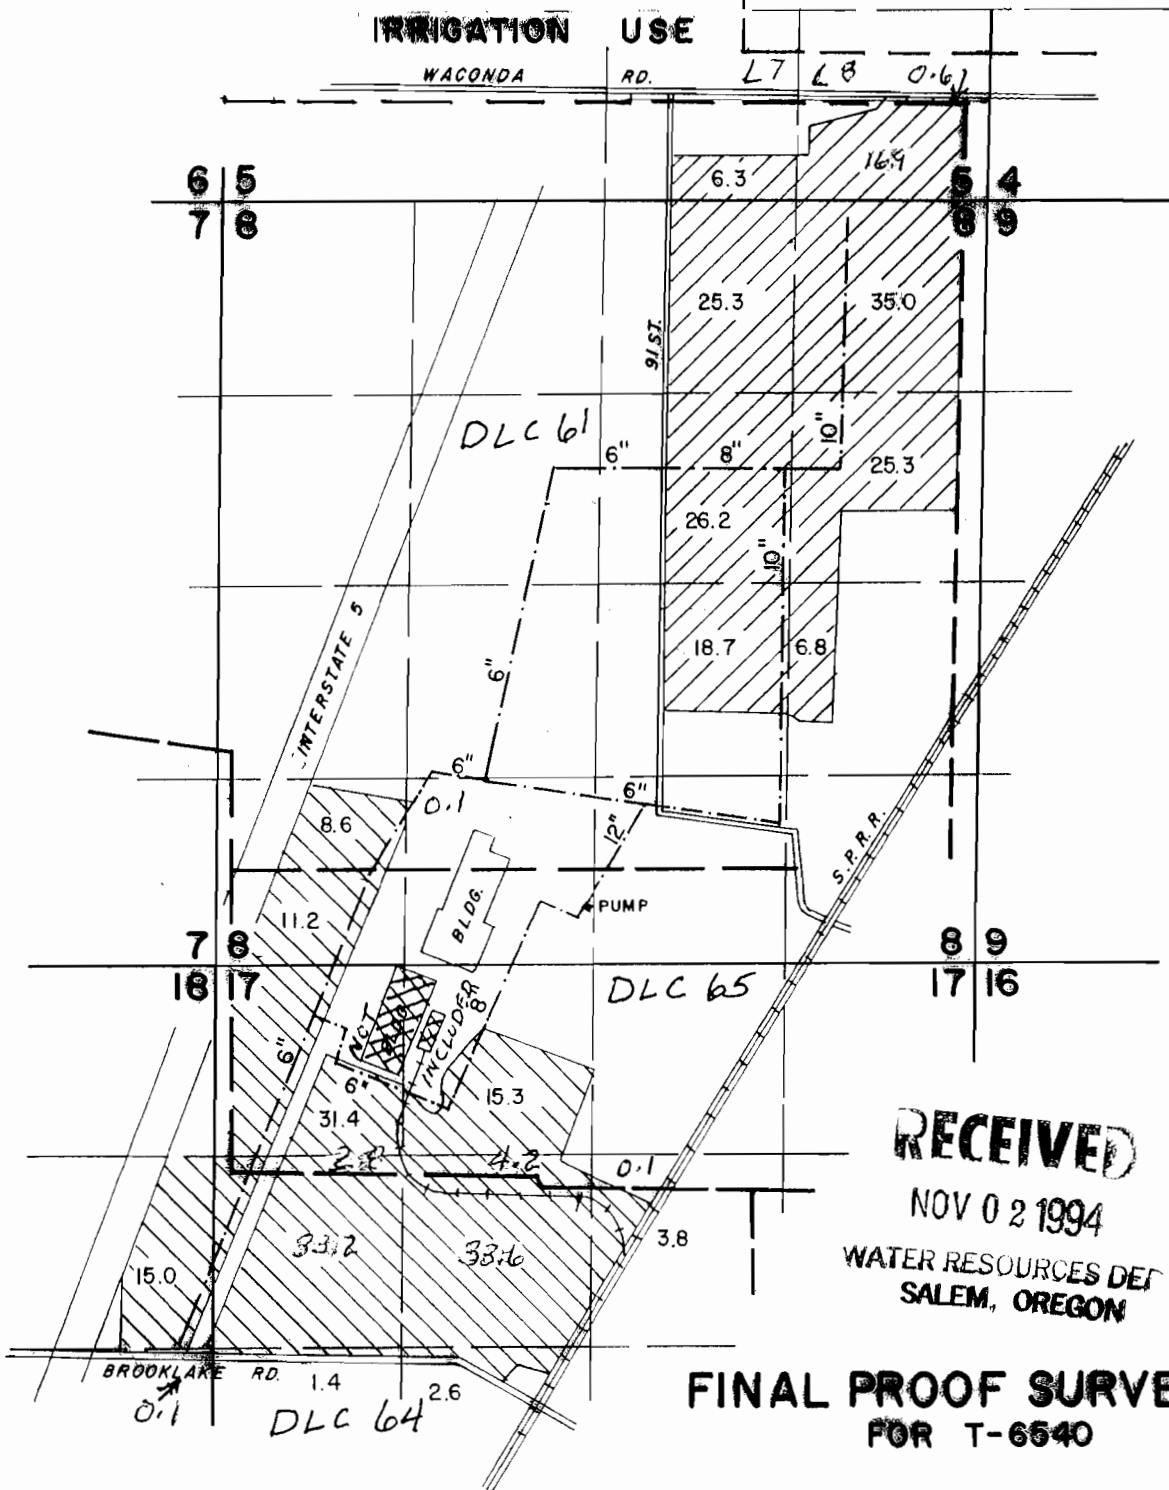


RECEIVED

NOV 02 1994

WATER RESOURCES DIV
SALEM, OREGON

**FINAL PROOF SURVEY
FOR T-6540**

BY:

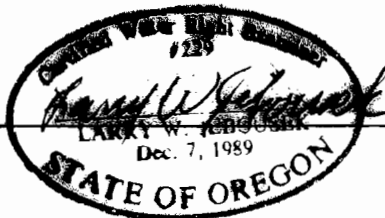

THIS MAP WAS PREPARED FOR THE PURPOSE OF IDENTIFYING THE LOCATION OF A WATER RIGHT ONLY AND IS NOT INTENDED TO PROVIDE LEGAL DIMENSIONS OR LOCATION OF PROPERTY OWNERSHIP LINES.

AMENDED 4/12/07 LHN WRD