

T. 6 S. R. 2 W. W.M. NORPAC BROOKS PLANT

IRRIGATION USE

WACONDA RD.

RD.

L7

L8

0.61

6
7

5
8

6.3

16.9

5
8


4
9



N



4" = 1 MI.

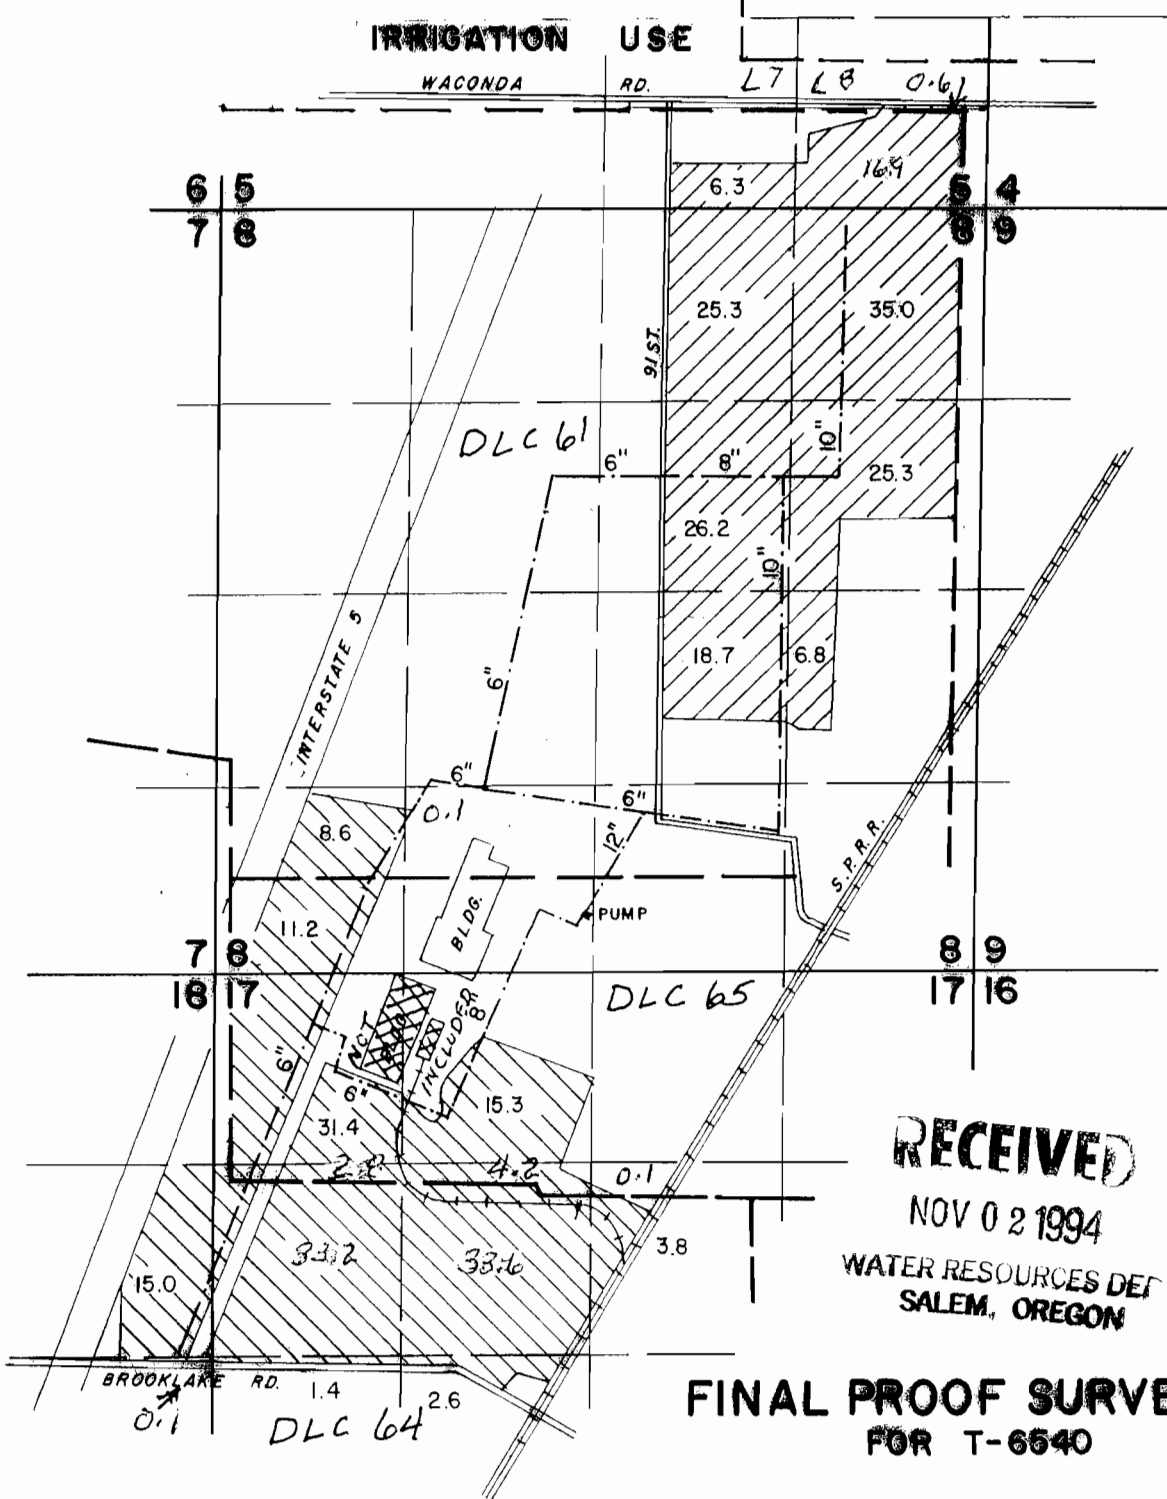


RECEIVED

NOV 02 1994

WATER RESOURCES DEPT
SALEM, OREGON

**FINAL PROOF SURVEY

BY:

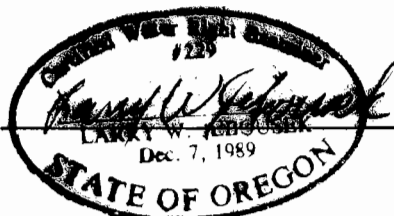

THIS MAP WAS PREPARED FOR THE PURPOSE OF IDENTIFYING THE LOCATION OF A WATER RIGHT ONLY AND IS NOT INTENDED TO PROVIDE LEGAL DIMENSIONS OR LOCATION OF PROPERTY OWNERSHIP LINES.

AMENDED 4/12/07 LHN WRD