


T.27S.,R.15E.,W.M.

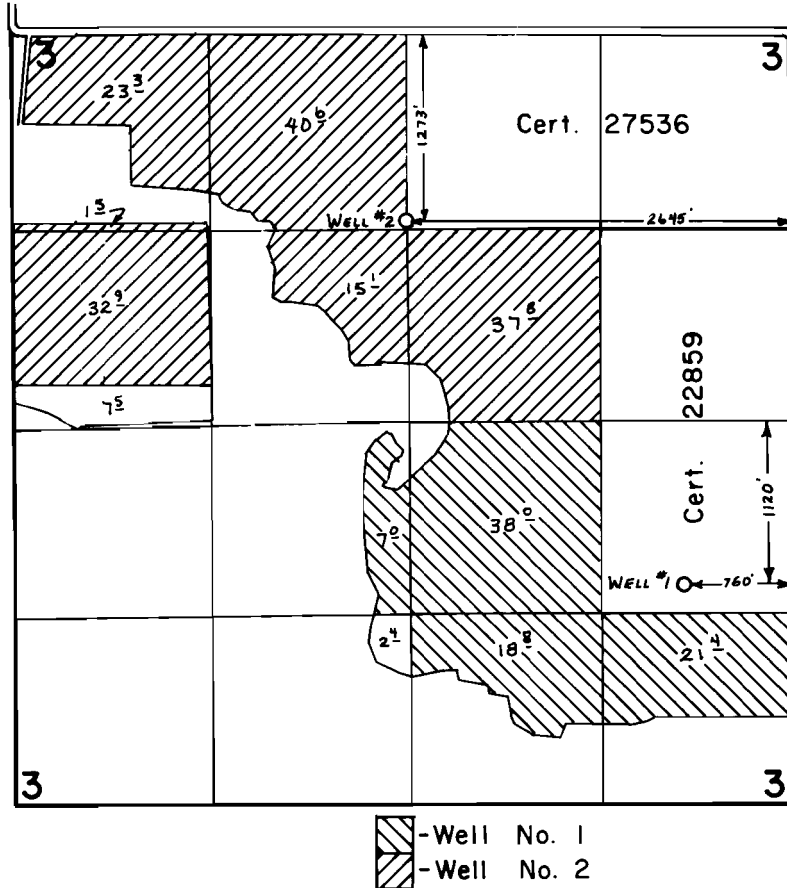

FINAL PROOF SURVEY UNDER

Application No. G-7605. Permit No. G-7054.....
IN NAME OF

.....O. R. HEAVILIN.....

Surveyed July 26, 1983., by L. M. TOLL.....